

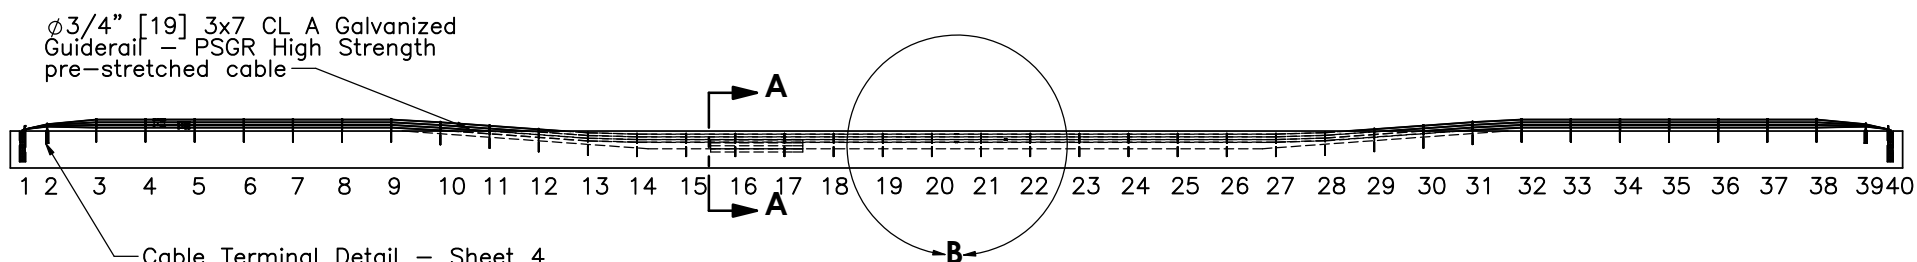


PLAN VIEW

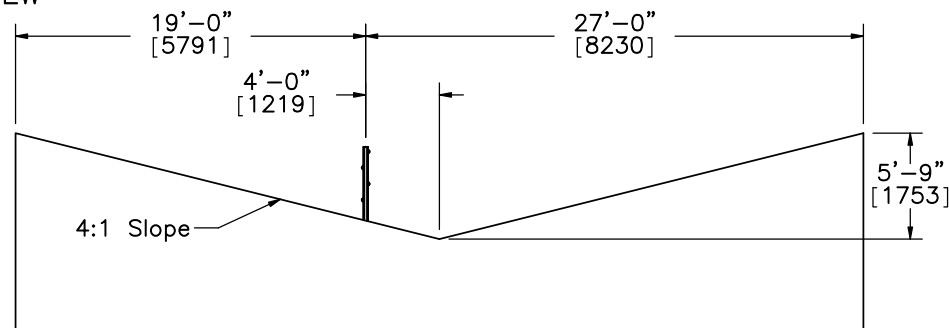

ELEVATION VIEW

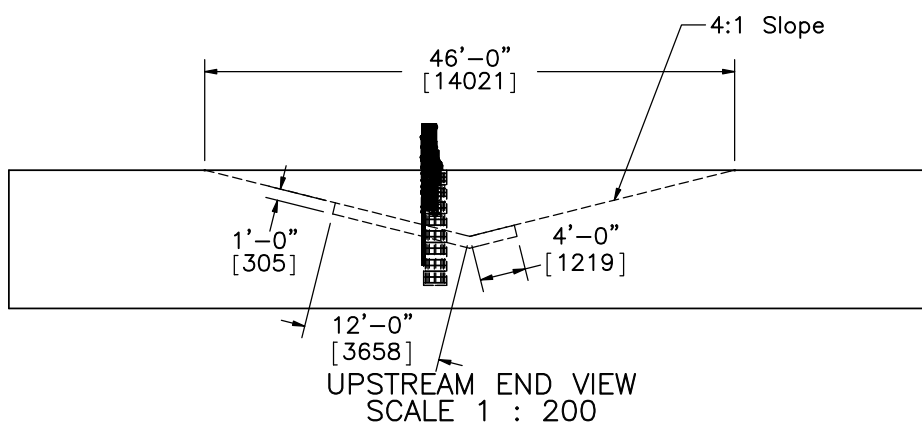

SECTION A-A
SCALE 1:125

Notes: (1) Post Nos. 1-9 and 32-40 are flared over 1' [305] to account for post nos. 1 and 40 being offset 3' [914] instead of 4' [1219].

(2) Impact point at 5'-4" [1626] downstream of post no. 17 was used to allow for the potential maximum underride of the vehicle.

(3) Post nos. 15-24 placed in barrels as detailed on sheet 18.

(4) Clip type and locations noted on sheet 23.




Midwest Roadside
Safety Facility

4-Cable Median Barrier
System Layout - 4CMB-4


DWG. NAME.
4CMB-4_R9

SCALE: 1:750
UNITS: In./mm

SHEET:
1 of 23
DATE:
11/17/11
DRAWN BY:
MJW/MDM/
JGP
REV. BY:
KAL/CLM/
RWB


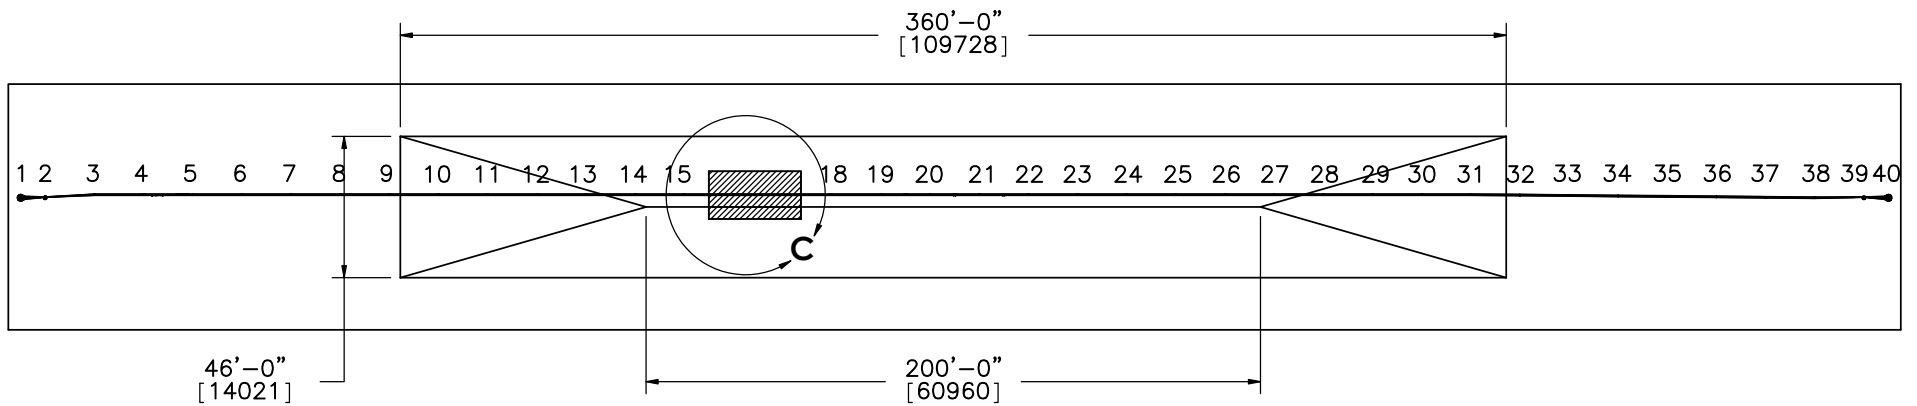


- Notes:
- (1) Well compacted NCHRP 350 soil region is to begin 13'-4" [4064] upstream from impact point.
 - (2) Slope between post nos. 14 and 20 must be within testing tolerance of 1/4" [6.4].
 - (3) Slope between post nos. 20 and 23 should be reasonably close but does not have to be exact

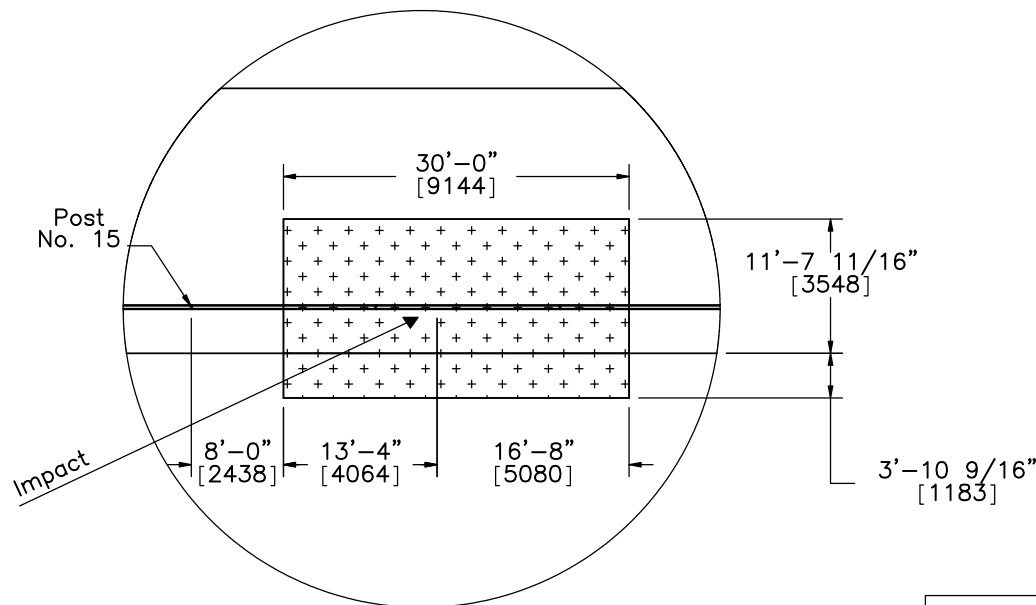


DETAIL C
SCALE 1 : 200

	4-Cable Median Barrier		SHEET: 2 of 23
	Soil Detail View		DATE: 11/17/11
Midwest Roadside Safety Facility	DWG. NAME: 4CMB-4_R9		DRAWN BY: MJW/MDM/ JGP
	SCALE: 1:750 UNITS: In./mm		REV. BY: KAL/CLM/ RWB

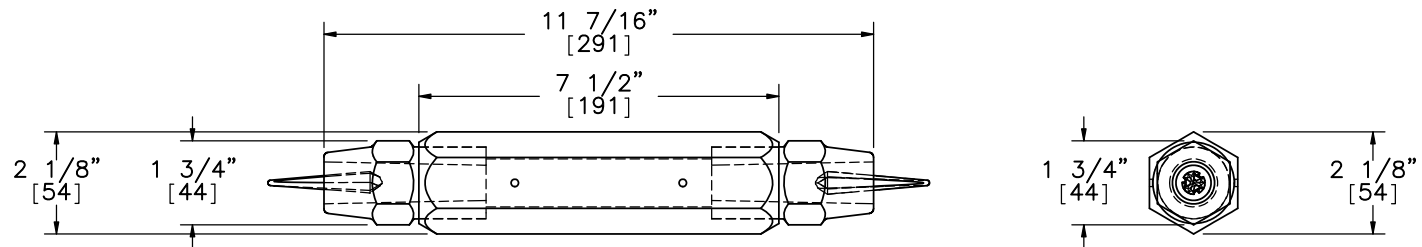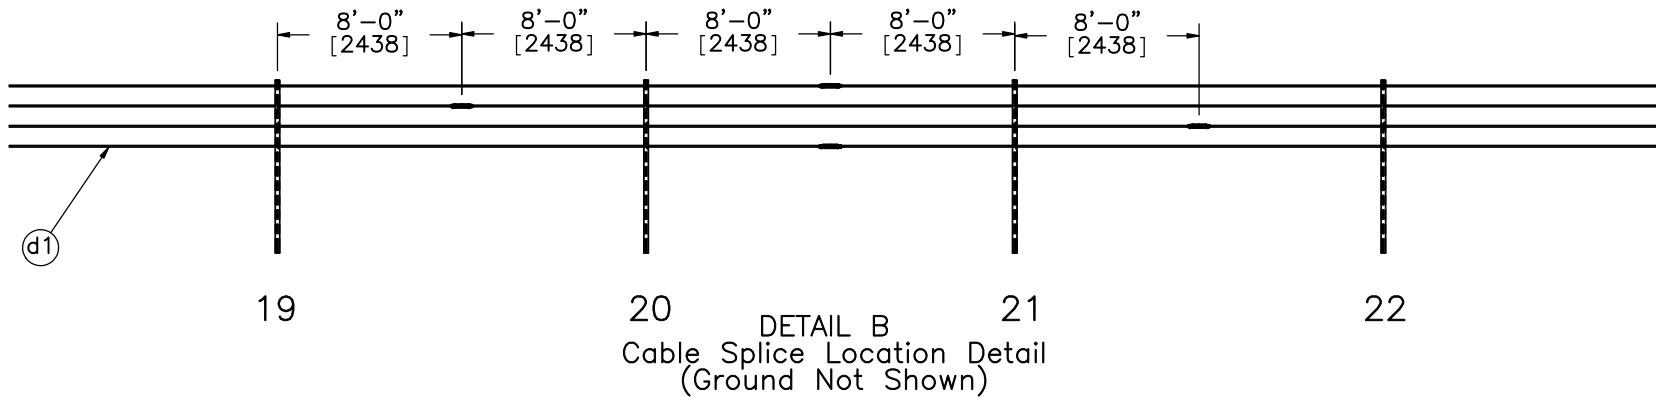

Cable Splice Detail

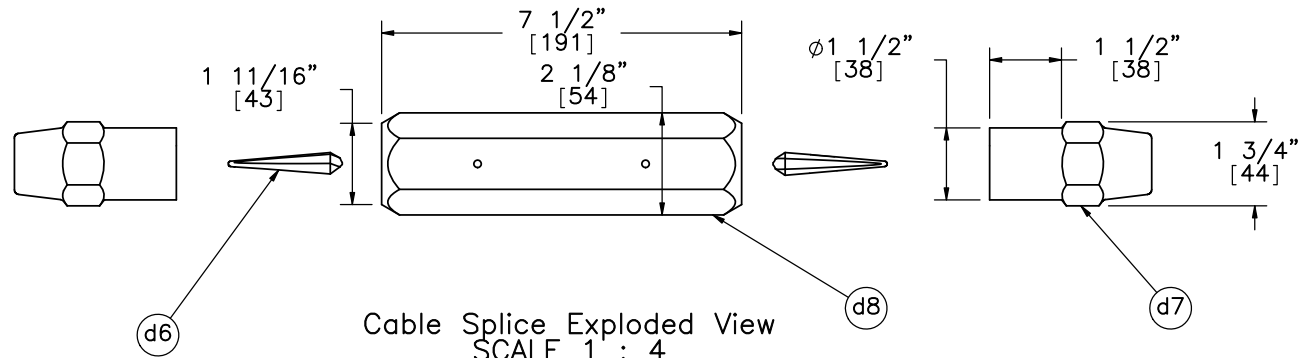


Midwest Roadside
Safety Facility

4-Cable Median Barrier
Cable Splice Location and Detail

DWG. NAME.
4CMB-4_R9

SCALE: 1:100
UNITS: In./mm

SHEET:
3 of 23
DATE:
11/17/11
DRAWN BY:
MJW/MDM/
JGP
REV. BY:
KAL/CLM/
RWB

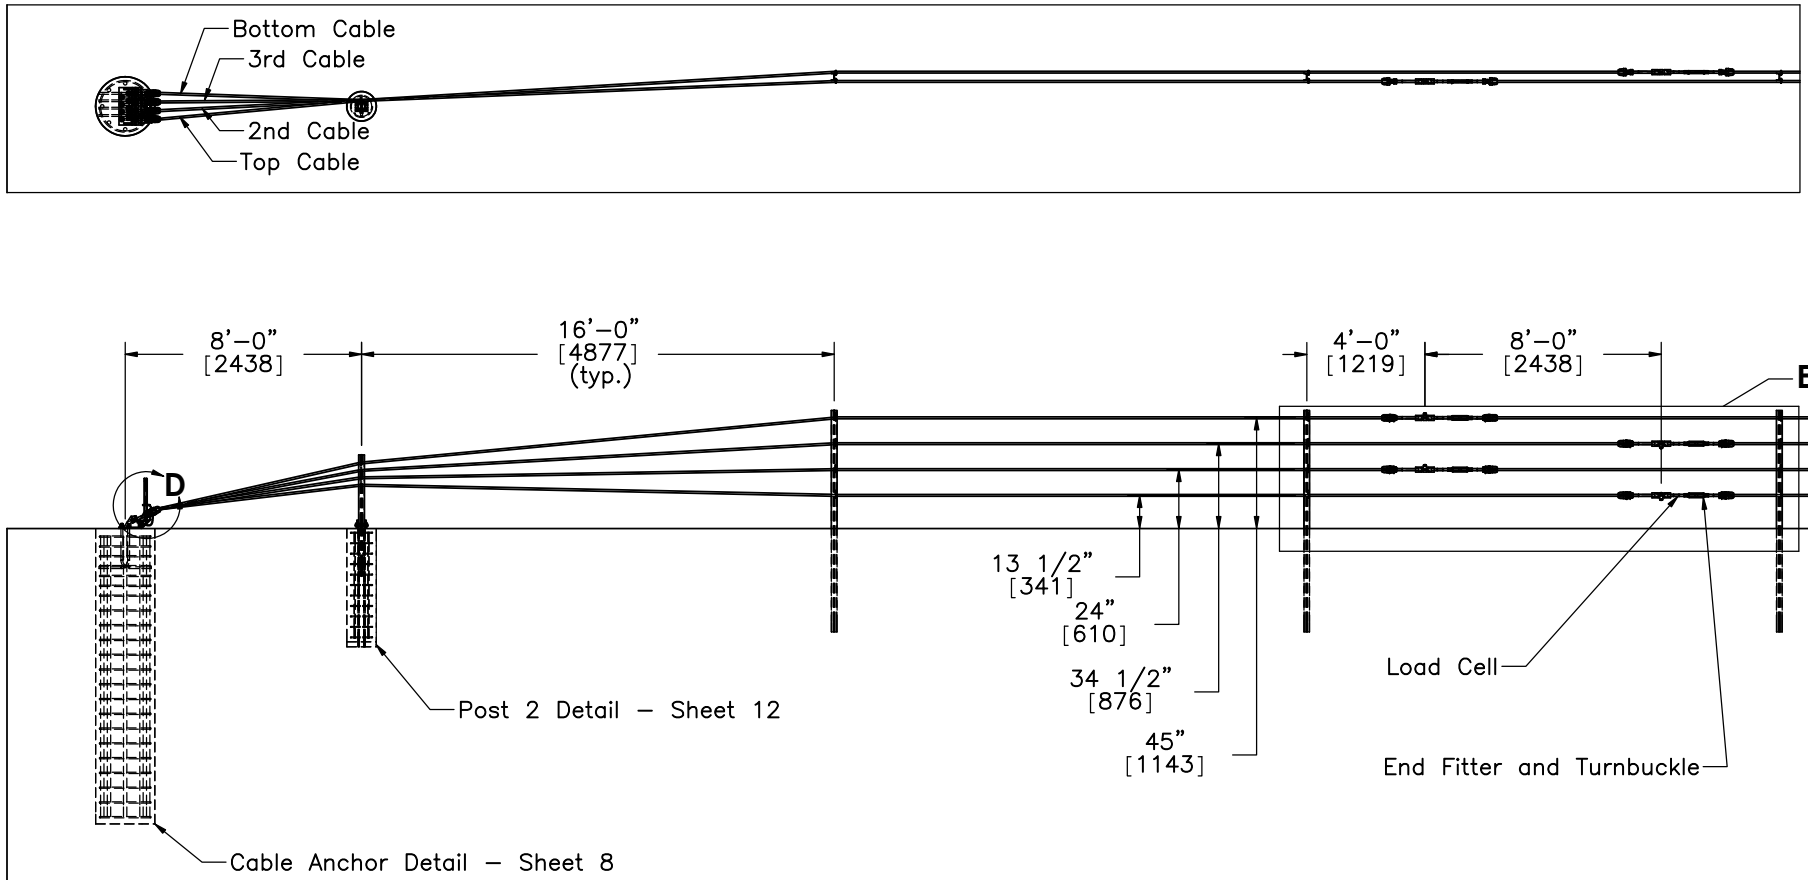

Midwest Roadside
Safety Facility


4-Cable Median Barrier

Cable Terminal Detail
As Built

DWG. NAME.
4CMB-4_R9

SCALE: 1:78
UNITS: In./mm

SHEET:
4 of 23
DATE:
11/17/11
DRAWN BY:
MJW/MDM/
JGP
REV. BY:
KAL/CLM/
RWB

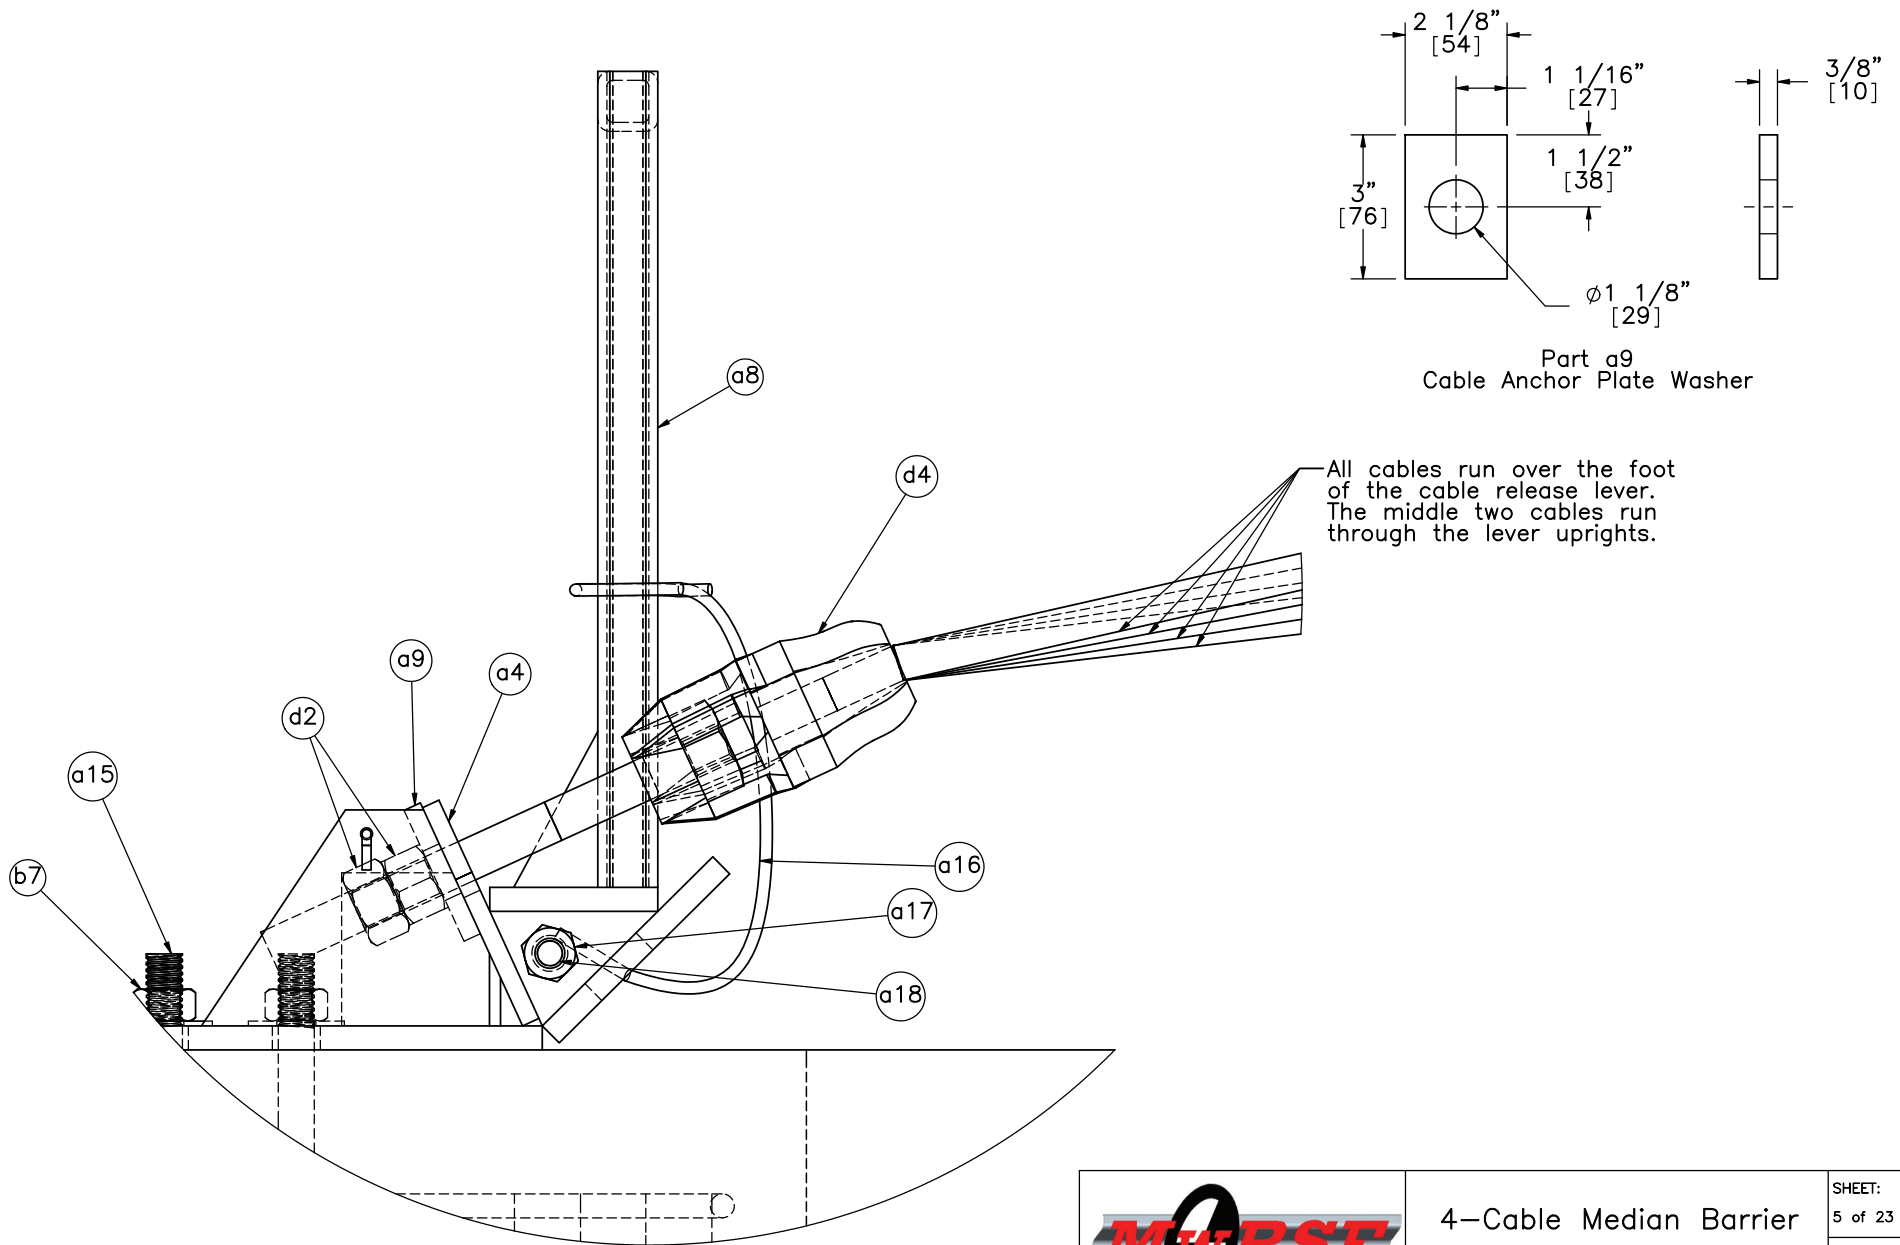

DETAIL D




Midwest Roadside
Safety Facility

4-Cable Median Barrier
Cable Anchor Details


DWG. NAME.
4CMB-4_R9

SCALE: 1:4
UNITS: In.[mm]

SHEET:
5 of 23
DATE:
11/17/11
DRAWN BY:
MJW/MDM/
JGP
REV. BY:
KAL/CLM/
RWB

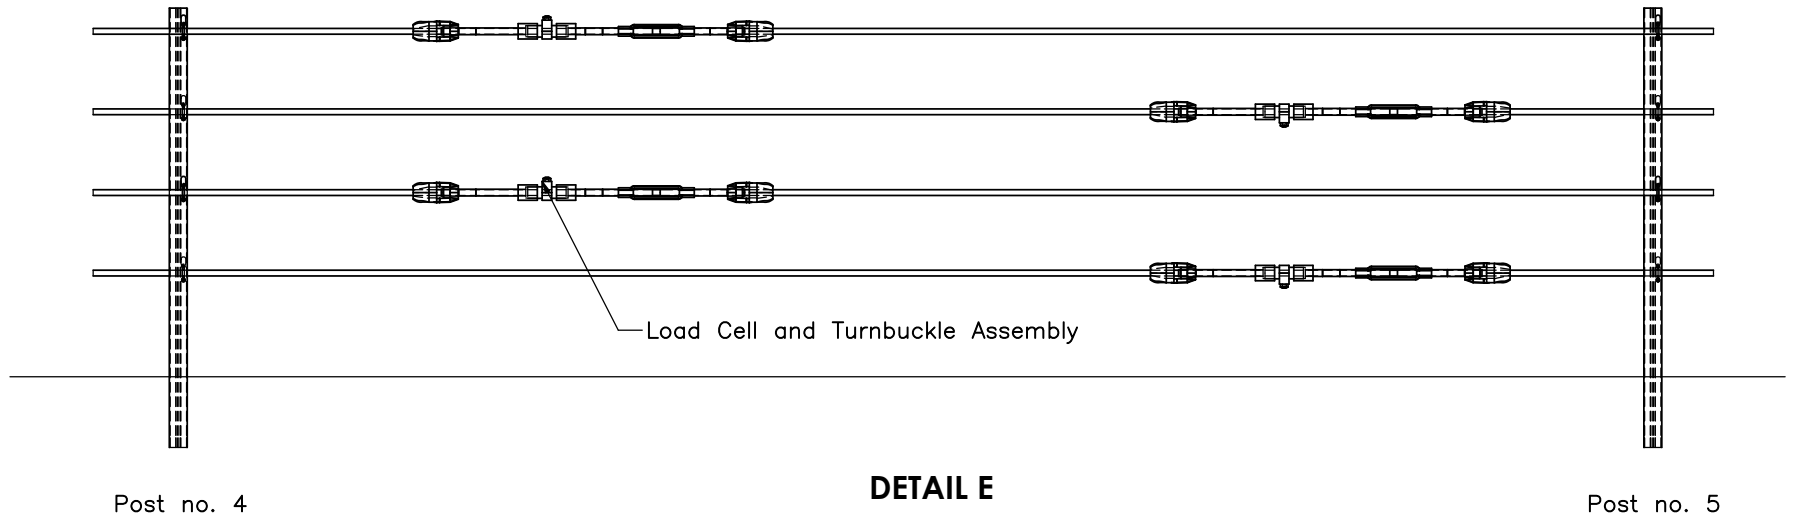


DETAIL E

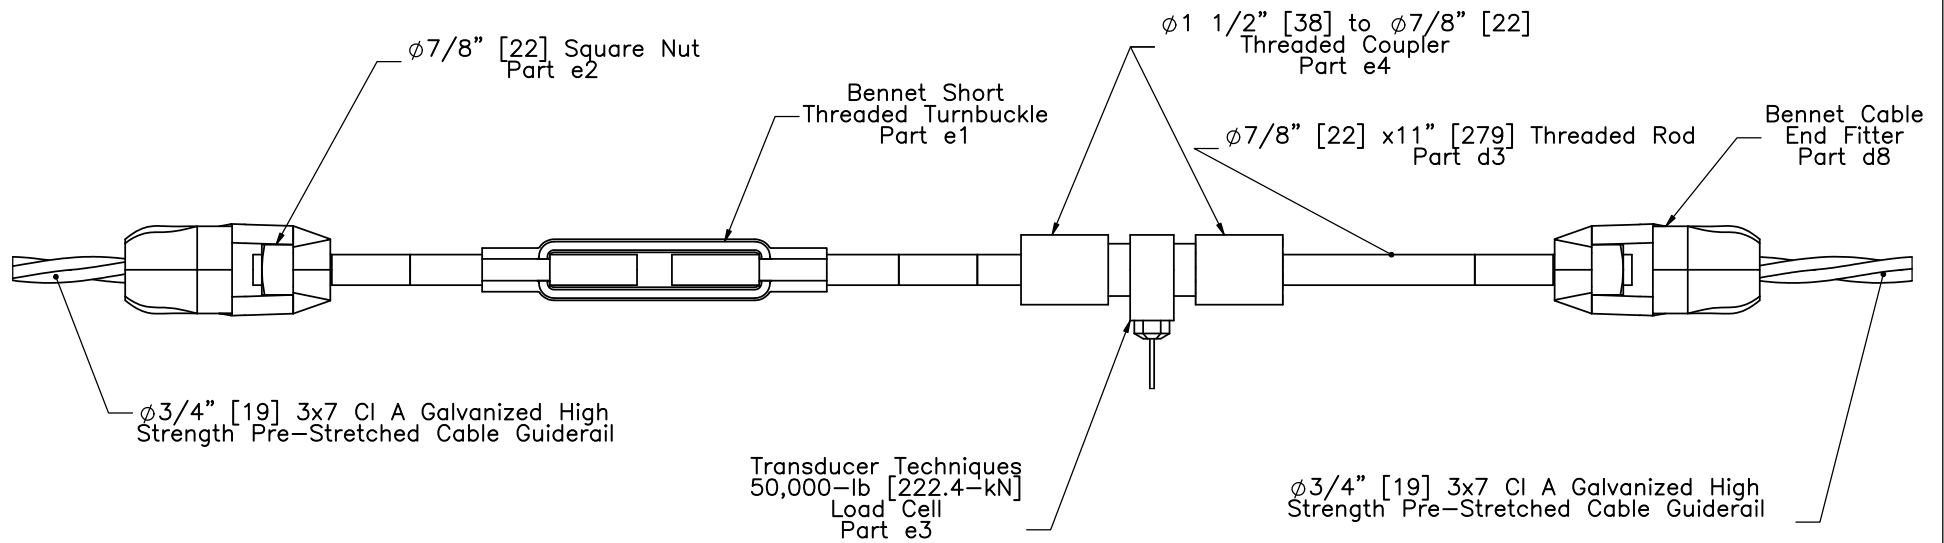


Note: Two RH-threaded rods and one LH-threaded rod required for load cell and turnbuckle assembly


	4-Cable Median Barrier		SHEET: 6 of 23
	Load Cell and Turnbuckle Configuration		DATE: 11/17/11
Midwest Roadside Safety Facility	DWG. NAME: 4CMB-4_R9		DRAWN BY: MJW/MDM/JGP
	SCALE: 1:25 UNITS: In./mm		REV. BY: KAL/CLM/RWB

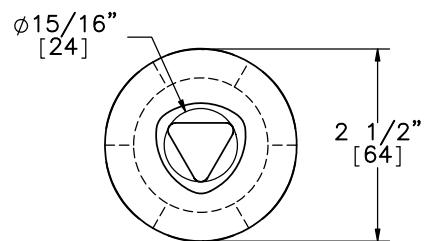


SECTION F-F

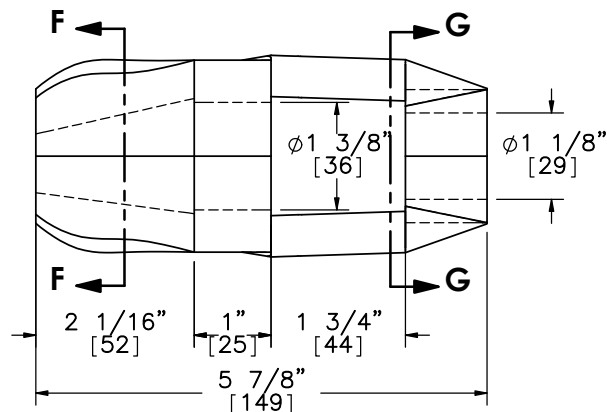


Bennet Cable End Fitter
Part d8

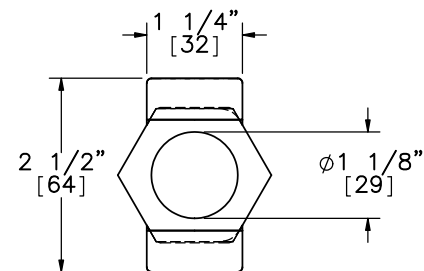


SECTION G-G

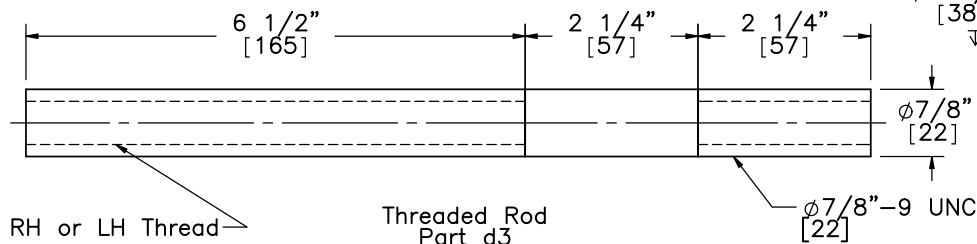

Threaded Rod
Part d3

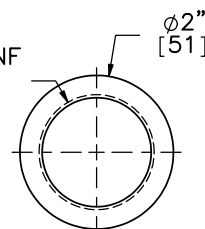


SECTION H-H


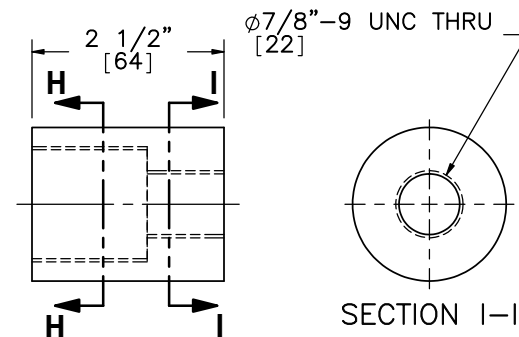


SECTION I-I

$\phi 1 \frac{1}{2}$ "-12 UNF Threaded Both Sides
[38]

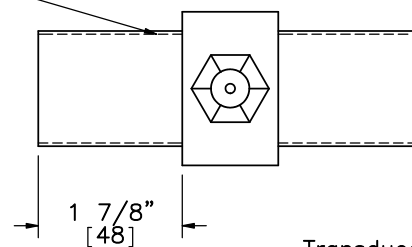

Transducer Techniques
50000-lb [222.4-kN] Rated Load Cell
Part e3

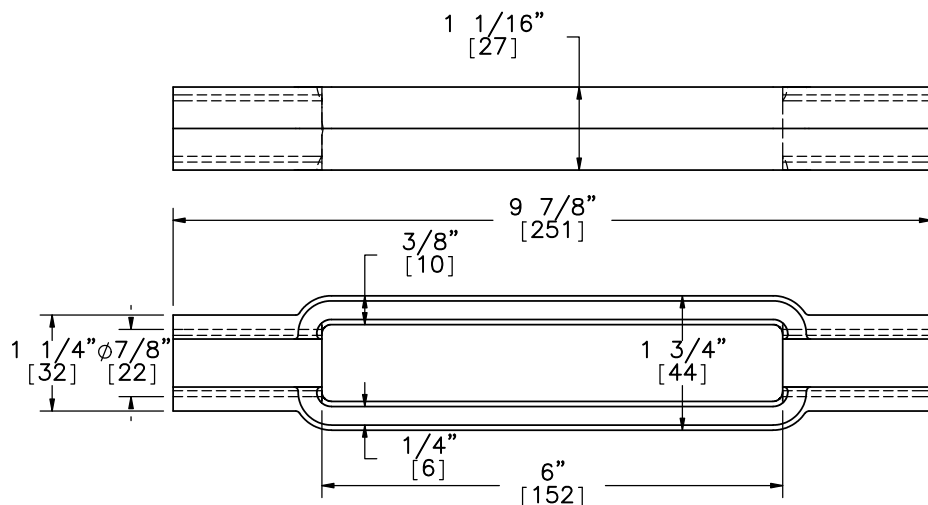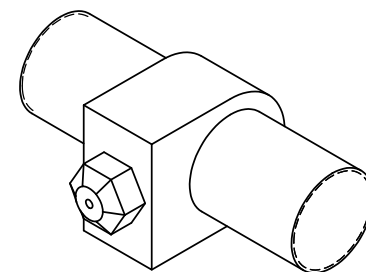

Bennet Threaded Turnbuckle
Part e1



Midwest Roadside
Safety Facility


4-Cable Median Barrier

Load Cell Assembly
Component Details


DWG. NAME.
4CMB-4_R9

SCALE: 1:2
UNITS: In.[mm]

SHEET:
7 of 23
DATE:
11/17/11
DRAWN BY:
MJW/MDM/
JGP
REV. BY:
KAL/CLM/
RWB

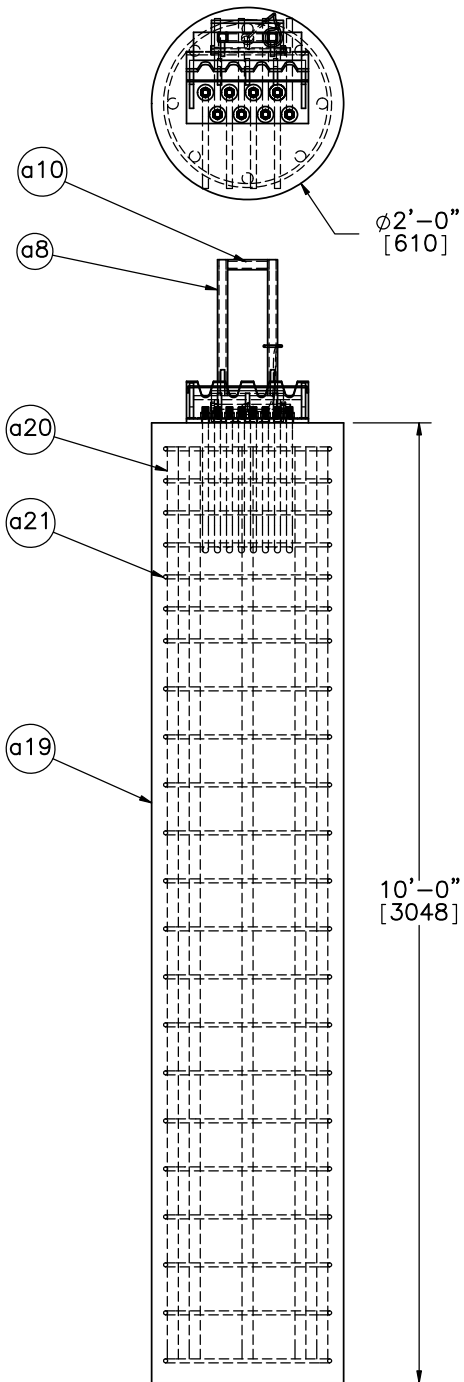

Brass Keeper Rod
 $\phi 3/16"$ [4.8] x 16" [406]
 long. Bend ends of rod
 to secure.
 Part a5

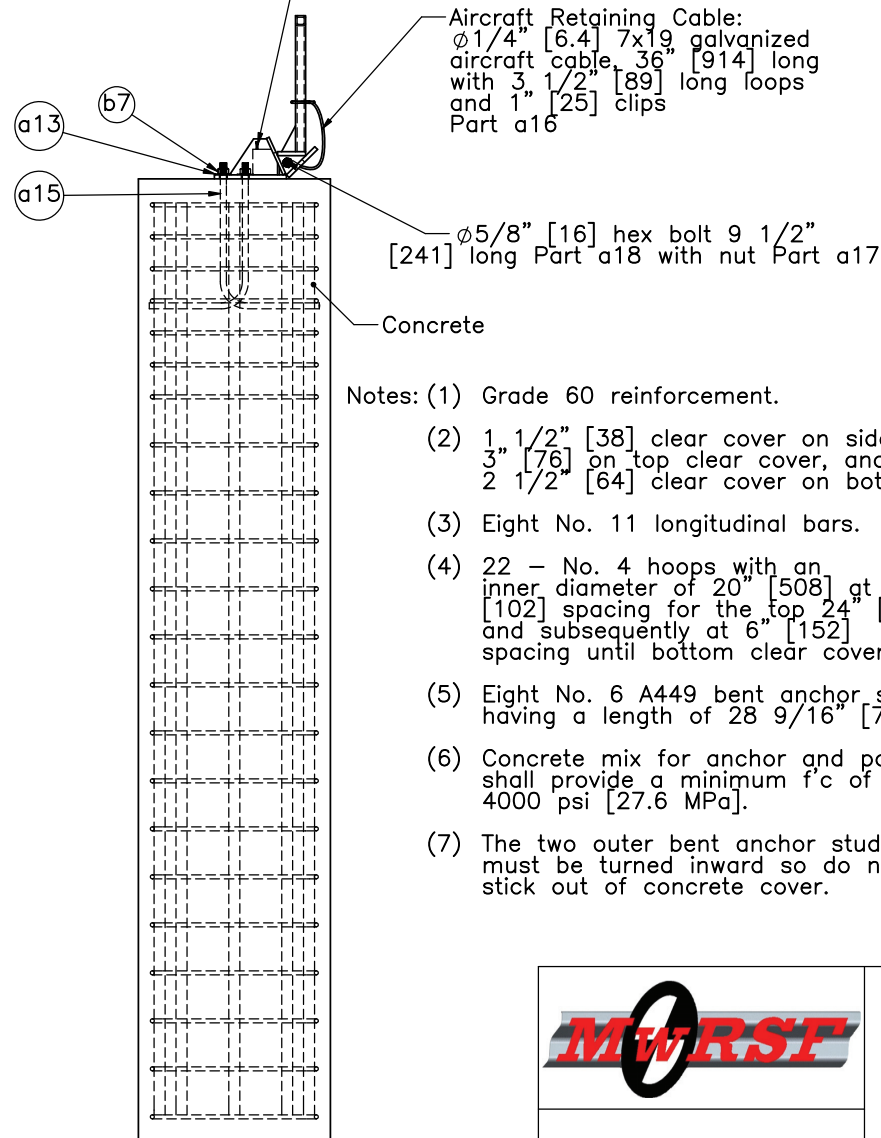

Note: Brass rod to be placed after all
 cables are installed and tensioned.
 Slide rod through the $1/4"$ [6.4] holes
 in the Anchor Bracket, leaving a
 minimum of 1" [25] on each side of
 the Anchor Bracket. Bend brass rod
 down on each side of Anchor
 Bracket to secure.

Aircraft Retaining Cable:
 $\phi 1/4"$ [6.4] 7x19 galvanized
 aircraft cable, 36" [914] long
 with 3, $1/2"$ [89] long loops
 and 1" [25] clips
 Part a16

$\phi 5/8"$ [16] hex bolt 9 $1/2"$
 [241] long Part a18 with nut Part a17

Concrete

Notes: (1) Grade 60 reinforcement.

(2) $1, 1/2"$ [38] clear cover on sides,
 $3"$ [76] on top clear cover, and
 $2, 1/2"$ [64] clear cover on bottom.


(3) Eight No. 11 longitudinal bars.

(4) 22 - No. 4 hoops with an
 inner diameter of 20" [508] at 4"
 [102] spacing for the top 24" [610]
 and subsequently at 6" [152]
 spacing until bottom clear cover.

(5) Eight No. 6 A449 bent anchor studs
 having a length of 28 $9/16"$ [725].

(6) Concrete mix for anchor and posts
 shall provide a minimum f'c of
 4000 psi [27.6 MPa].

(7) The two outer bent anchor studs
 must be turned inward so do not
 stick out of concrete cover.

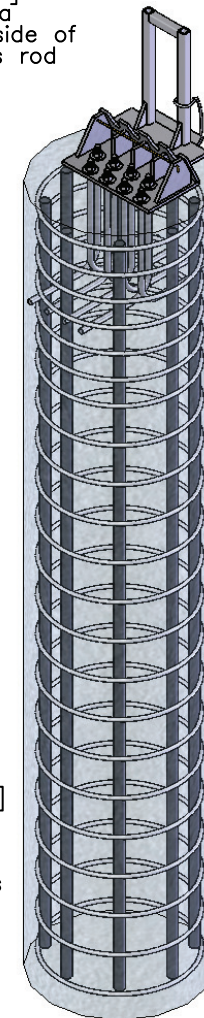

Midwest Roadside
 Safety Facility



4-Cable Median Barrier

Cable Anchor Detail
 Post Nos. 1 & 40
 As Built


DWG. NAME.
 4CMB-4_R9

SCALE: 1:24
 UNITS: In./mm

SHEET:
 8 of 23
 DATE:
 11/17/11
 DRAWN BY:
 MJW/MDM/
 JGP
 REV. BY:
 KAL/CLM/
 RWB

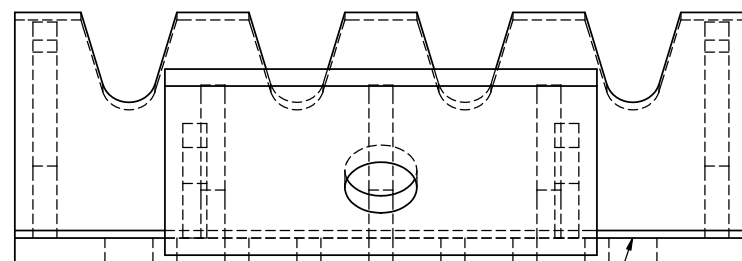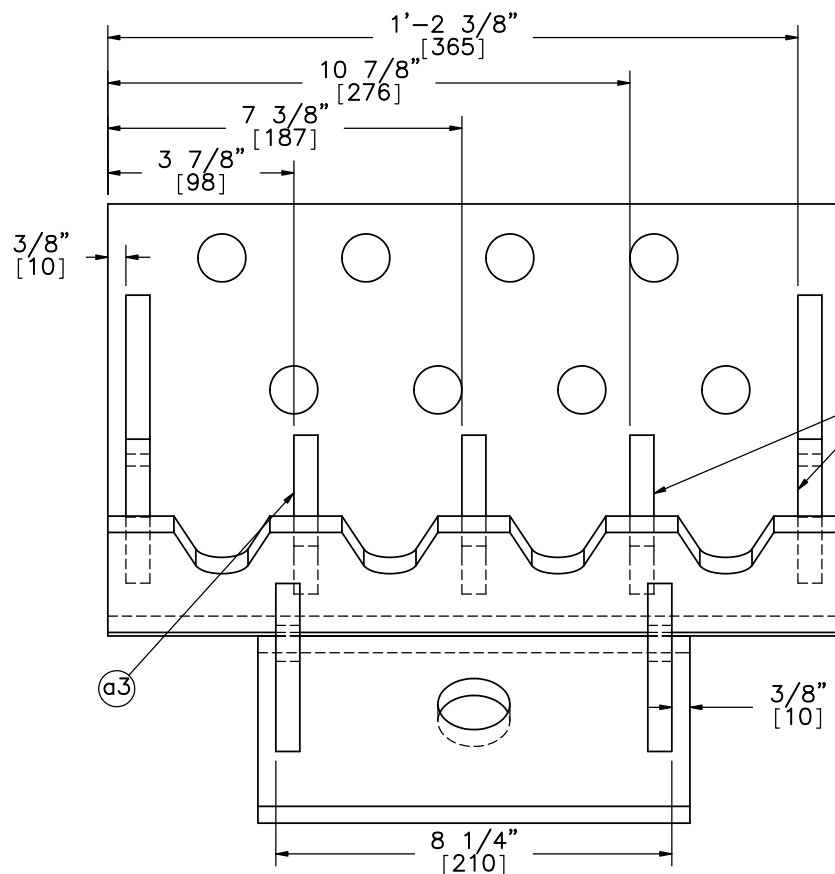


(typ.) 3/8" [10]
1/8" [3]

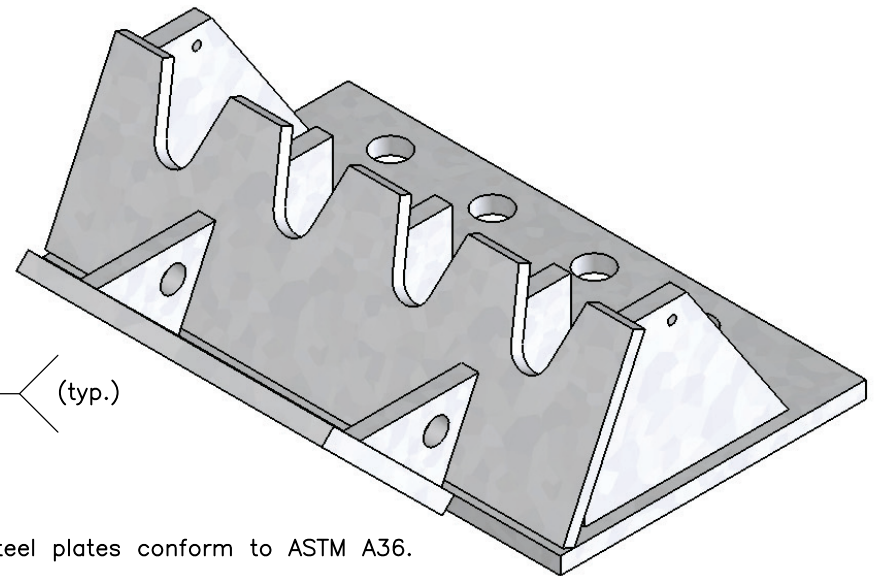

Notes: (1) All steel plates conform to ASTM A36.

(2) The cable anchor bracket is to be galvanized following fabrication.

(3) A continuous weld extending along the base of part a7 ground flush with the base plate and a continuous weld extending along the base of part a4 were used in lieu of the specified welds.

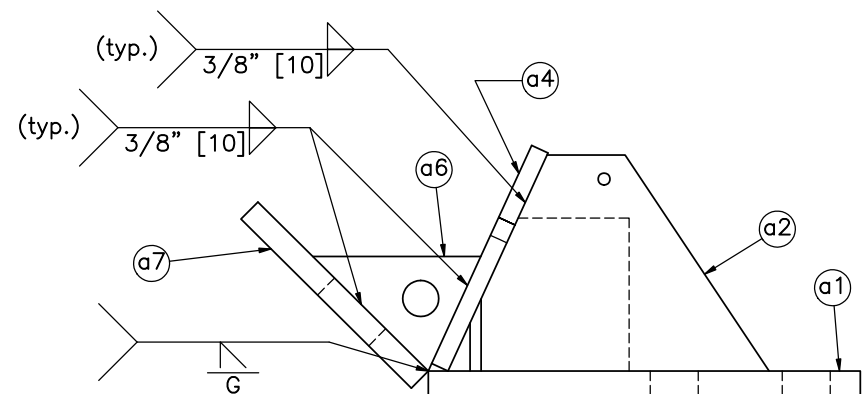


Midwest Roadside
Safety Facility

4-Cable Median Barrier
Cable Anchor Bracket




DWG. NAME.
4CMB-4_R9

SCALE: 1:4
UNITS: In.[mm]


SHEET:
9 of 23
DATE:
11/17/11
DRAWN BY:
MJW/MDM/
JGP
REV. BY:
KAL/CLM/
RWB

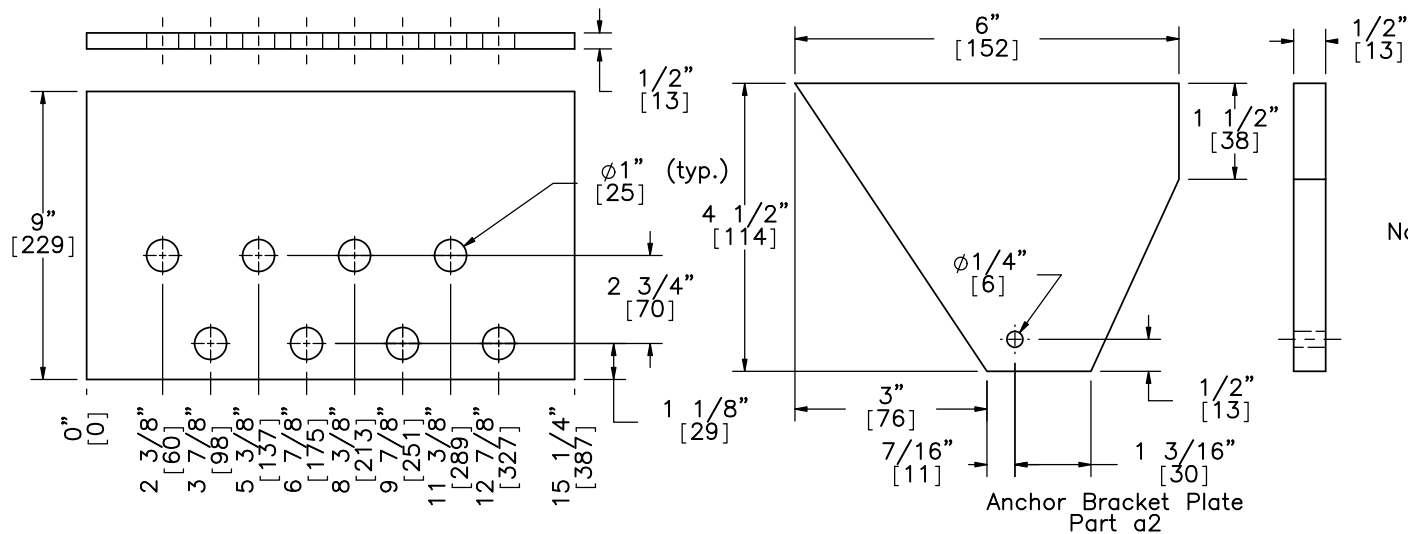

Note: All steel plates conform to ASTM A36.

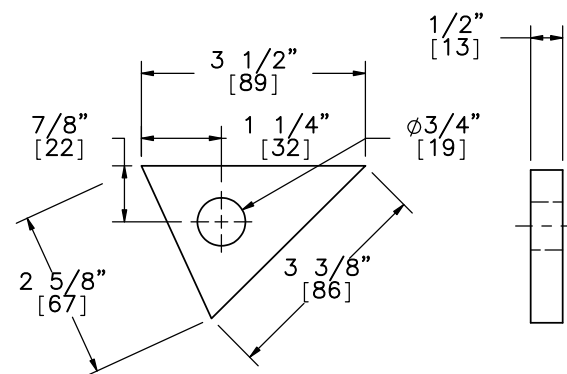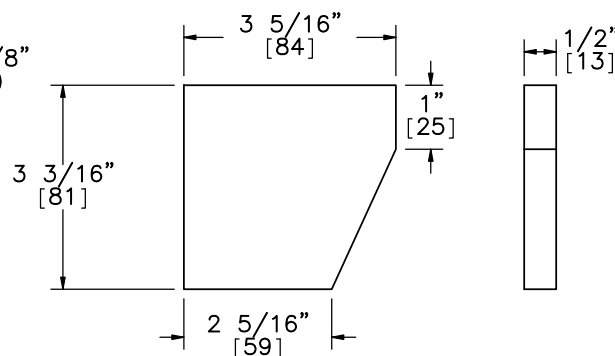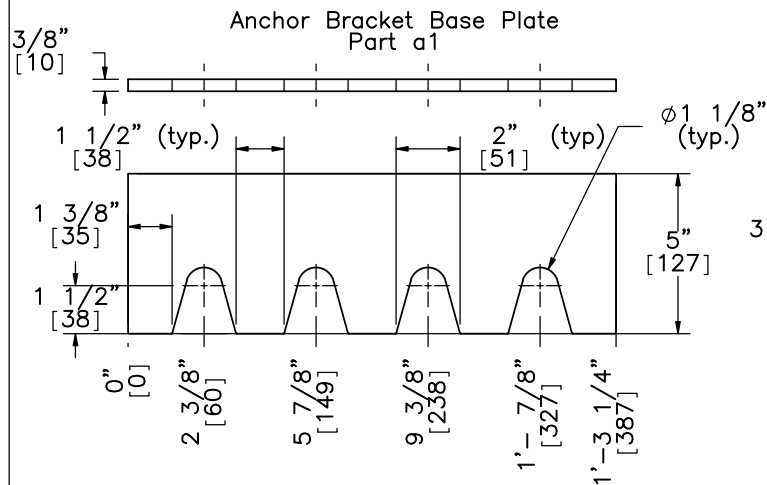

Anchor Bracket Plate
Part a4

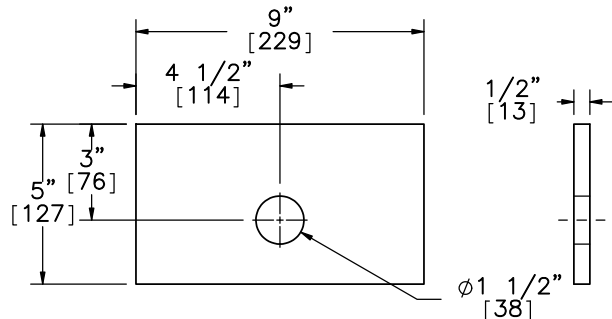

Anchor Bracket Plate
Part a7

Anchor Bracket Plate
Part a3

Anchor Bracket Plate
Part a6




Midwest Roadside
Safety Facility

4-Cable Median Barrier
Cable Anchor Bracket




DWG. NAME.
4CMB-4_R9

SCALE: 1:6
UNITS: In./mm

SHEET:
10 of 23
DATE:
11/17/11
DRAWN BY:
MJW/MDM/
JGP
REV. BY:
KAL/CLM/
RWB

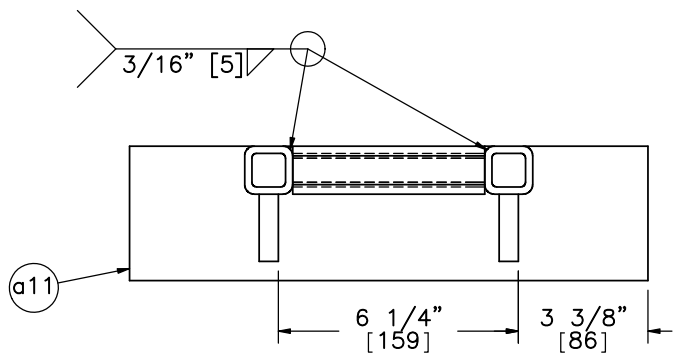

- Notes: (1) The kicker lever should be flush with the top of the kicker plate.
- (2) The 3 1/4" [83] leg of the kicker plate gusset should line up with the kicker lever.
- (3) The bottom of the cable release lever should rest upon part a6.
- (4) All steel plates conform to ASTM A36.
- (5) All steel tubing conforms to ASTM A500 Grade B.

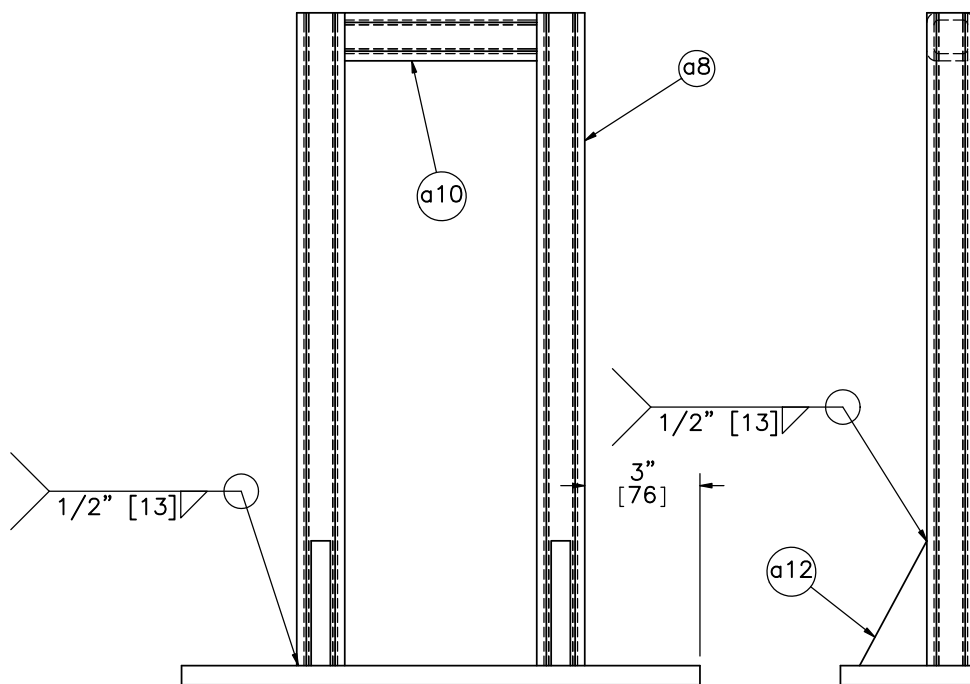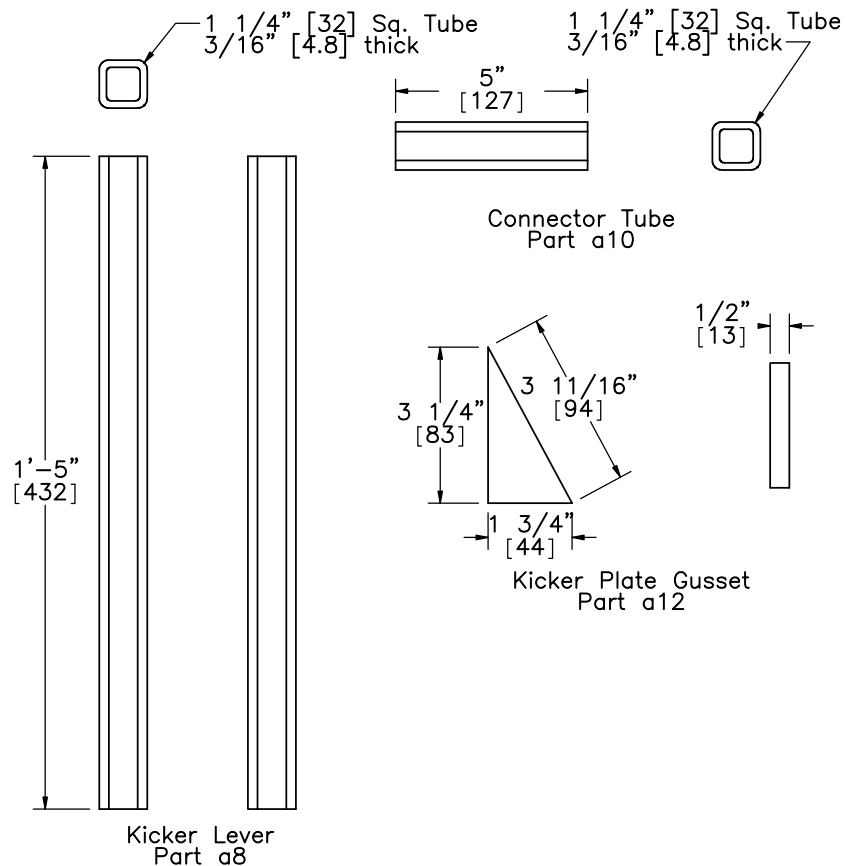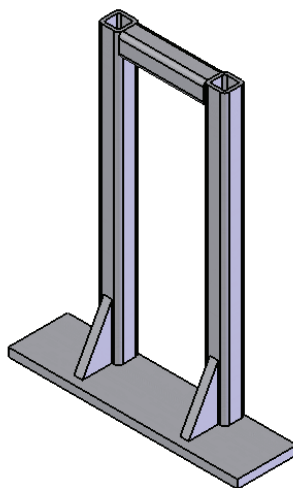

Cable Release Lever





Midwest Roadside
Safety Facility

4-Cable Median Barrier
Cable Release Lever


DWG. NAME.
4CMB-4_R9

SCALE: 1:5
UNITS: In./mm


SHEET:
11 of 23
DATE:
11/17/11
DRAWN BY:
MJW/MDM/
JGP
REV. BY:
KAL/CLM/
RWB

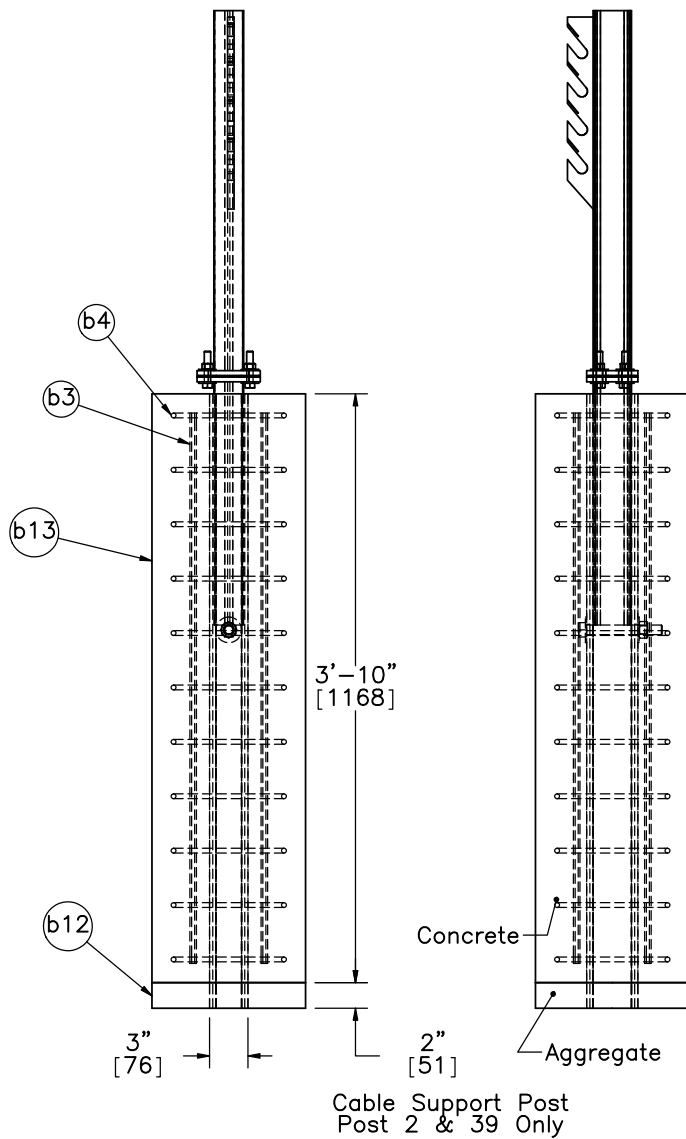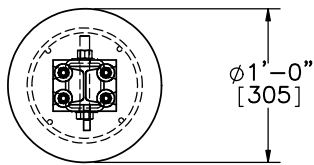

- Notes:
- (1) Grade 60 Reinforcement.
 - (2) 1 1/2" [38] clear cover.
 - (3) 11 No. 3 hoops with an inner diameter of 7 1/4" [184] and a vertical spacing of 4 1/4" [108].
 - (4) 4 No. 3 longitudinal bars.
 - (5) Concrete mix for anchor posts shall provide a minimum f'_c of 4000 psi [27.6 MPa].

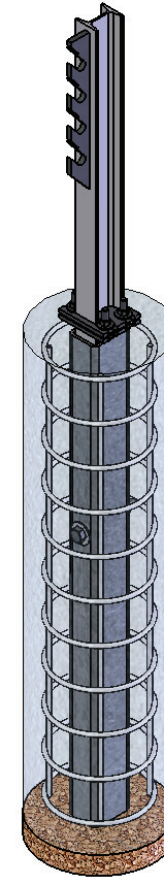

	4-Cable Median Barrier		SHEET: 12 of 23
	Second Post Detail Post Nos. 2 & 39 As Built		DATE: 11/17/11
Midwest Roadside Safety Facility	DWG. NAME: 4CMB-4_R9		DRAWN BY: MJW/MDM/ JGP
	SCALE: 1:15 UNITS: In./mm		REV. BY: KAL/CLM/ RWB

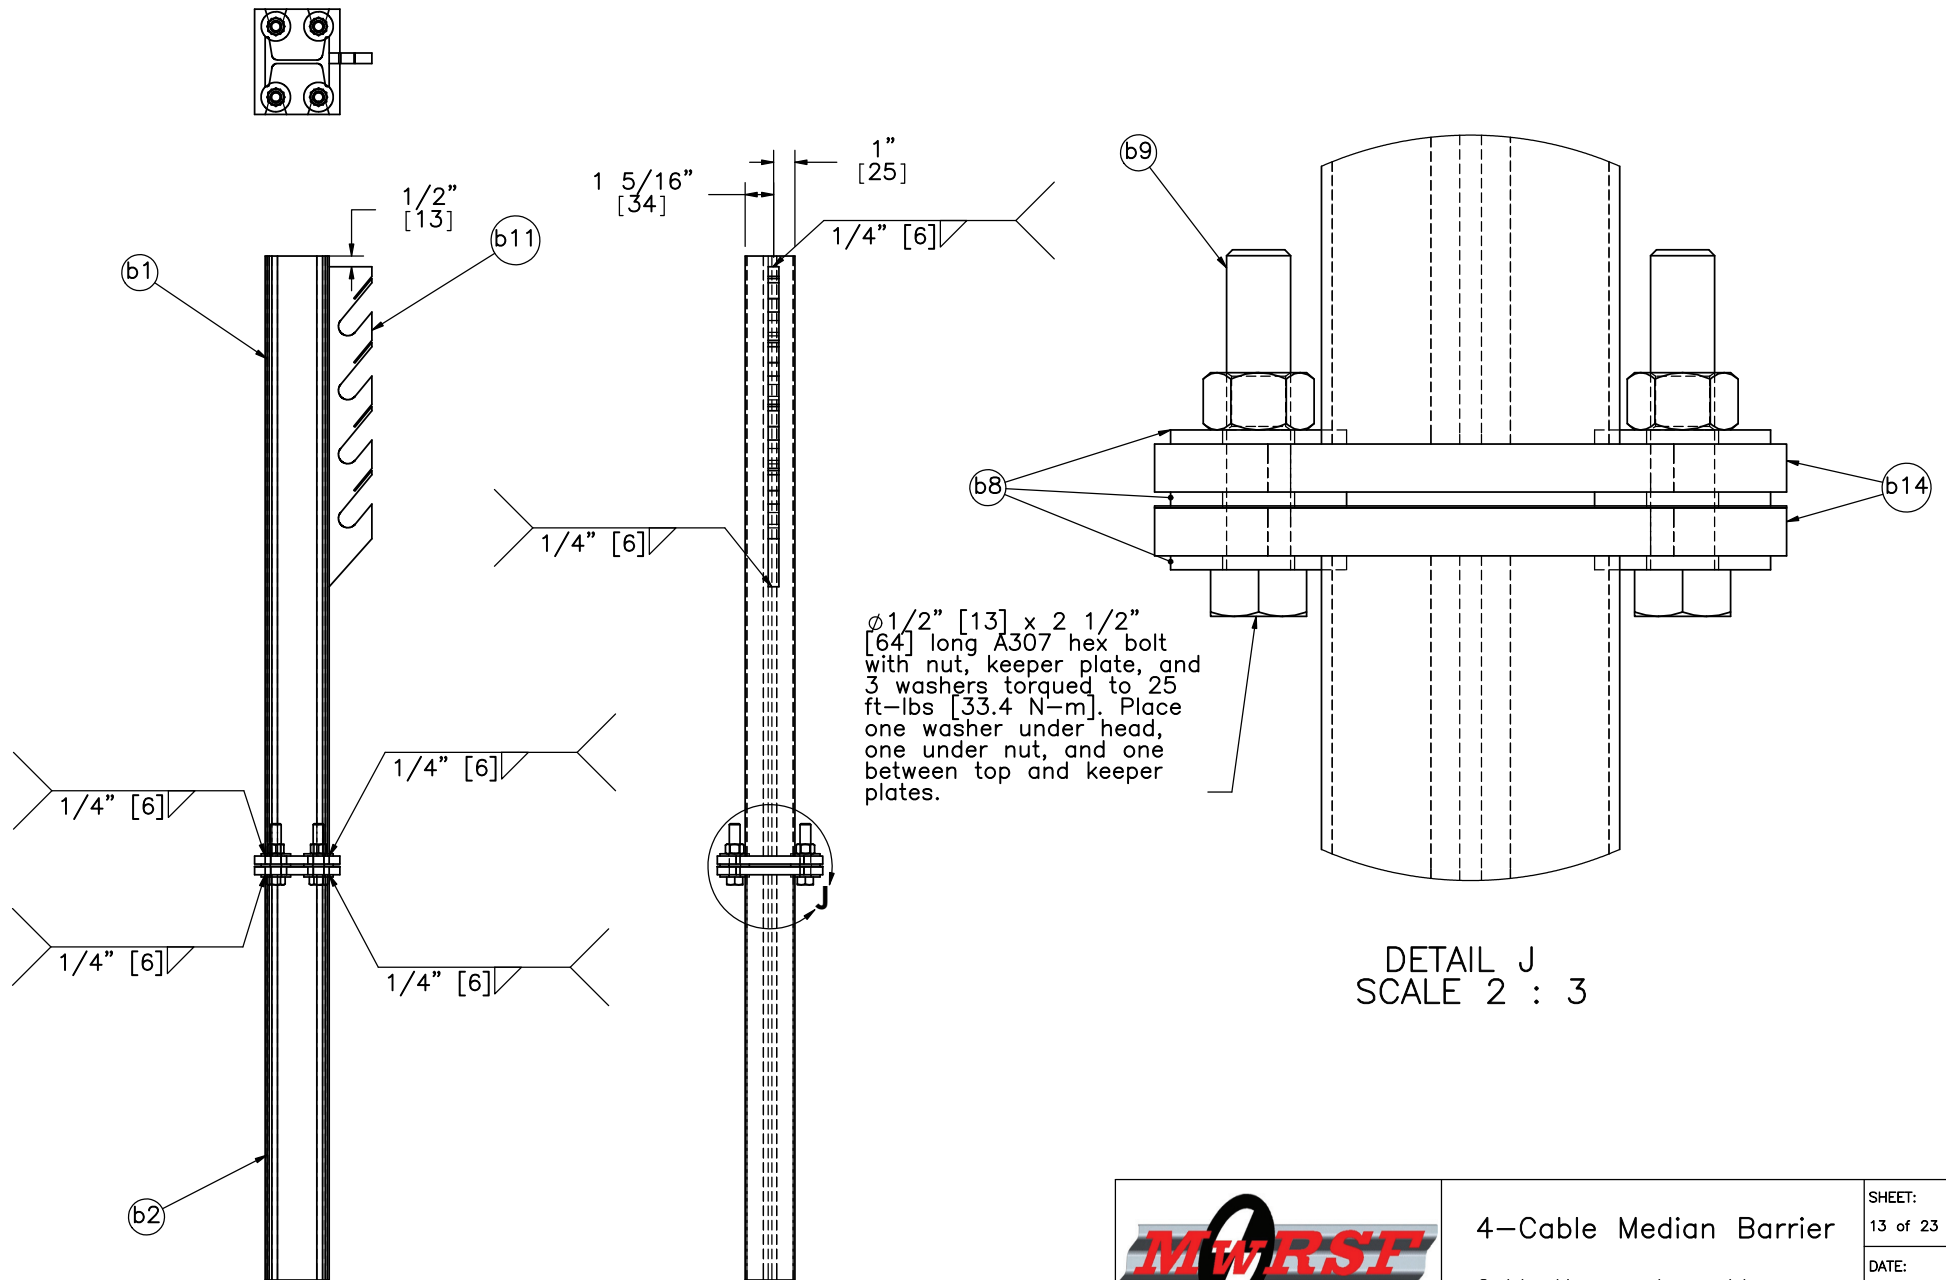

Midwest Roadside
Safety Facility

4-Cable Median Barrier

Cable Hanger Assembly
Post Nos. 2 & 39

DWG. NAME.
4CMB-4_R9


SCALE: 1:9
UNITS: In./mm

SHEET:
13 of 23



DATE:
11/17/11

DRAWN BY:
MJW/MDM/
JGP




REV. BY:
KAL/CLM/
RWB

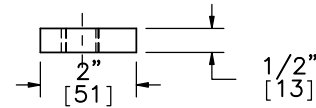

Note: Tabs to be bent after all cables have been installed and tensioned to secure.

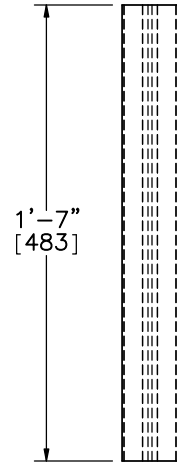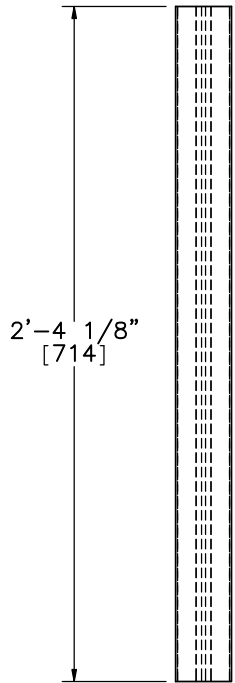


S3x5.7 [S76 x 8.5] Post
Part b2

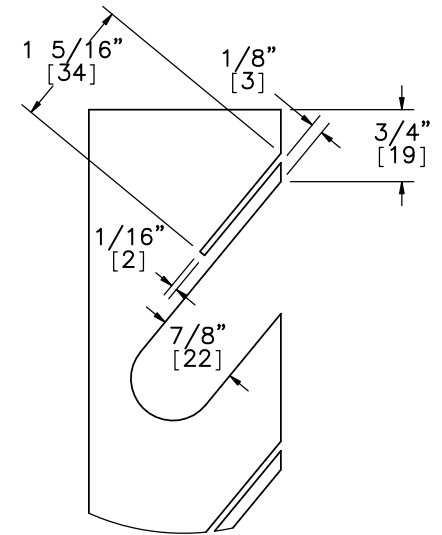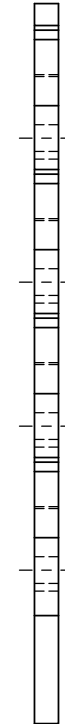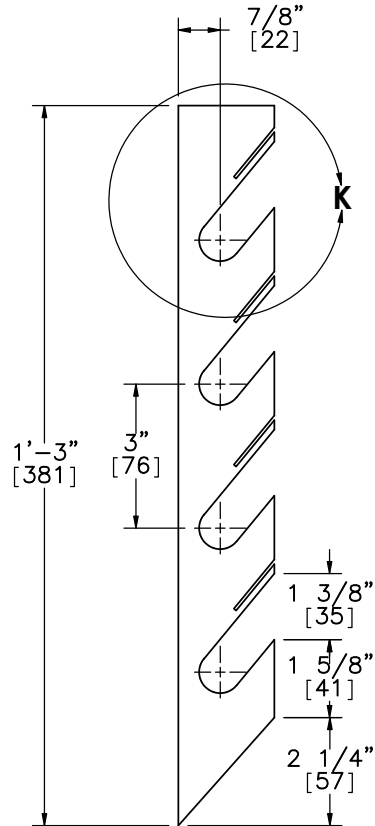


DETAIL K

S3x5.7 [S76 x 8.5] Post
Part b1

28 Gauge A36 Steel

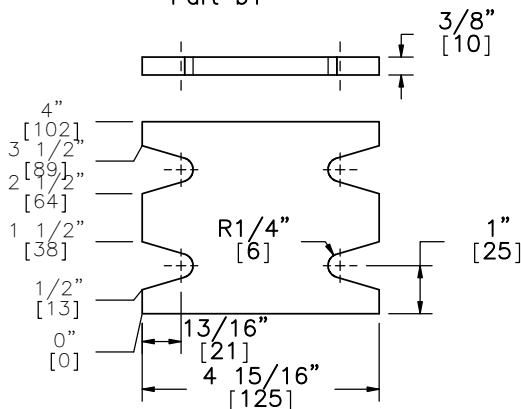

2nd Post Base Plate
Part b14

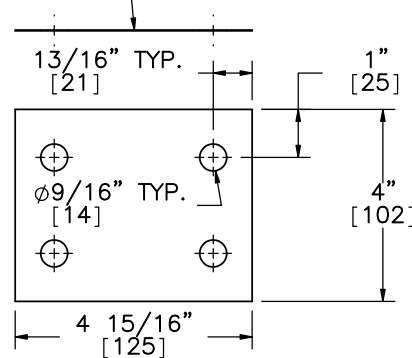

2nd Post Keeper Plate
Part b5

Cable Hanger
Part c12



Midwest Roadside
Safety Facility



4-Cable Median Barrier

Cable Hanger Assembly
Post Nos. 2 & 39

DWG. NAME.
4CMB-4_R9



SCALE: 1:8
UNITS: In./mm

SHEET:
14 of 23
DATE:
11/17/11
DRAWN BY:
MJW/MDM/
JGP
REV. BY:
KAL/CLM/
RWB

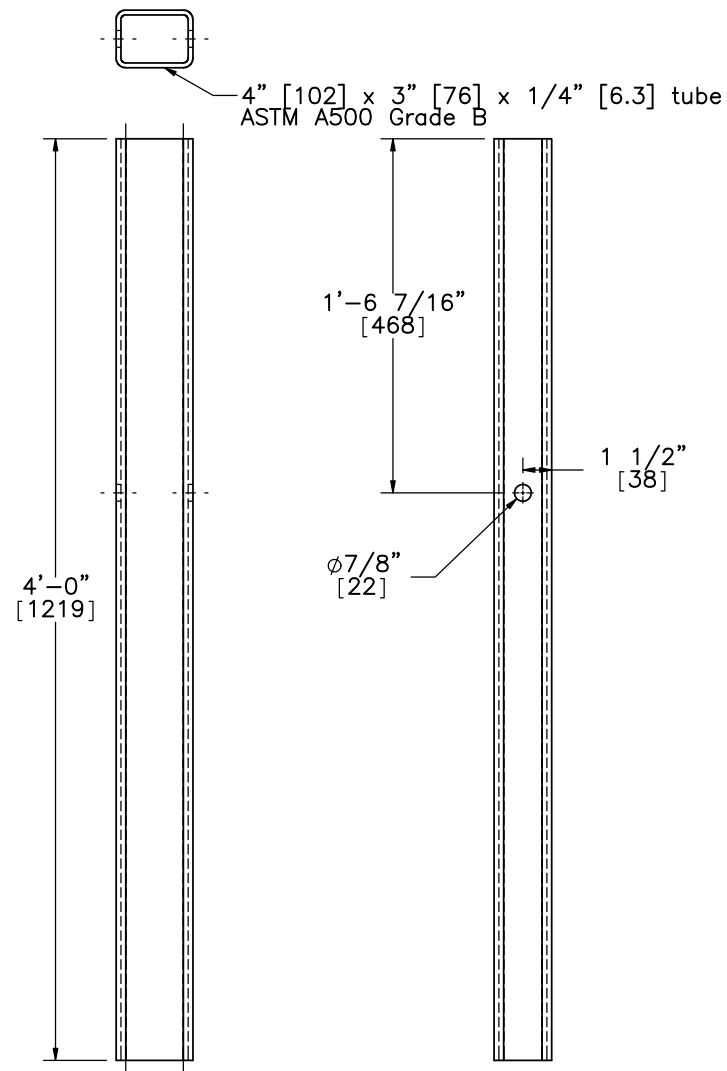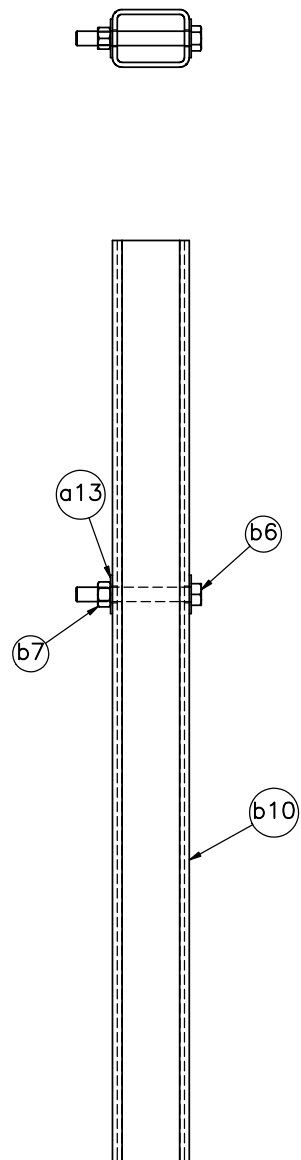


2nd Post Foundation Tube
Part b11

	4-Cable Median Barrier		SHEET: 15 of 23
	Foundation Tube Assembly Post Nos. 2 & 39		DATE: 11/17/11
Midwest Roadside Safety Facility	DWG. NAME: 4CMB-4_R9		DRAWN BY: MJW/MDM/ JGP
	SCALE: 1:10 UNITS: In.[mm]		REV. BY: KAL/CLM/ RWB

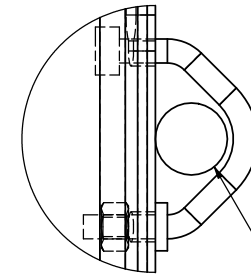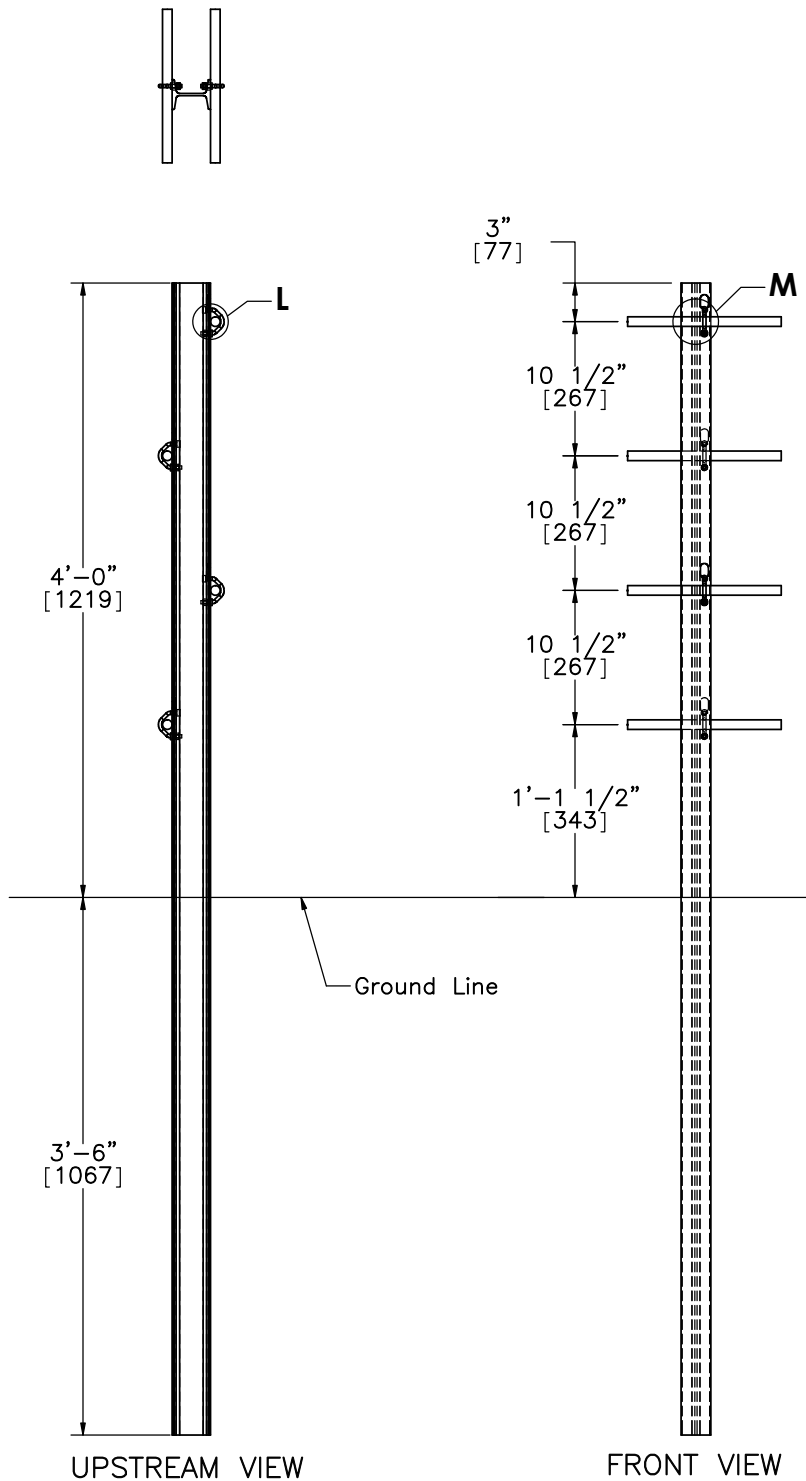



DETAIL L
SCALE 1 : 2

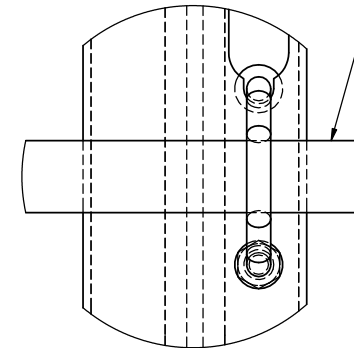

DETAIL M
SCALE 1 : 2

Cable

	4-Cable Median Barrier		SHEET: 16 of 23
	S3x5.7 Post Assembly		DATE: 11/17/11
Midwest Roadside Safety Facility	DWG. NAME: 4CMB-4_R9		DRAWN BY: MJW/MDM/ JGP
	SCALE: 1:15 UNITS: In./mm		REV. BY: KAL/CLM/ RWB

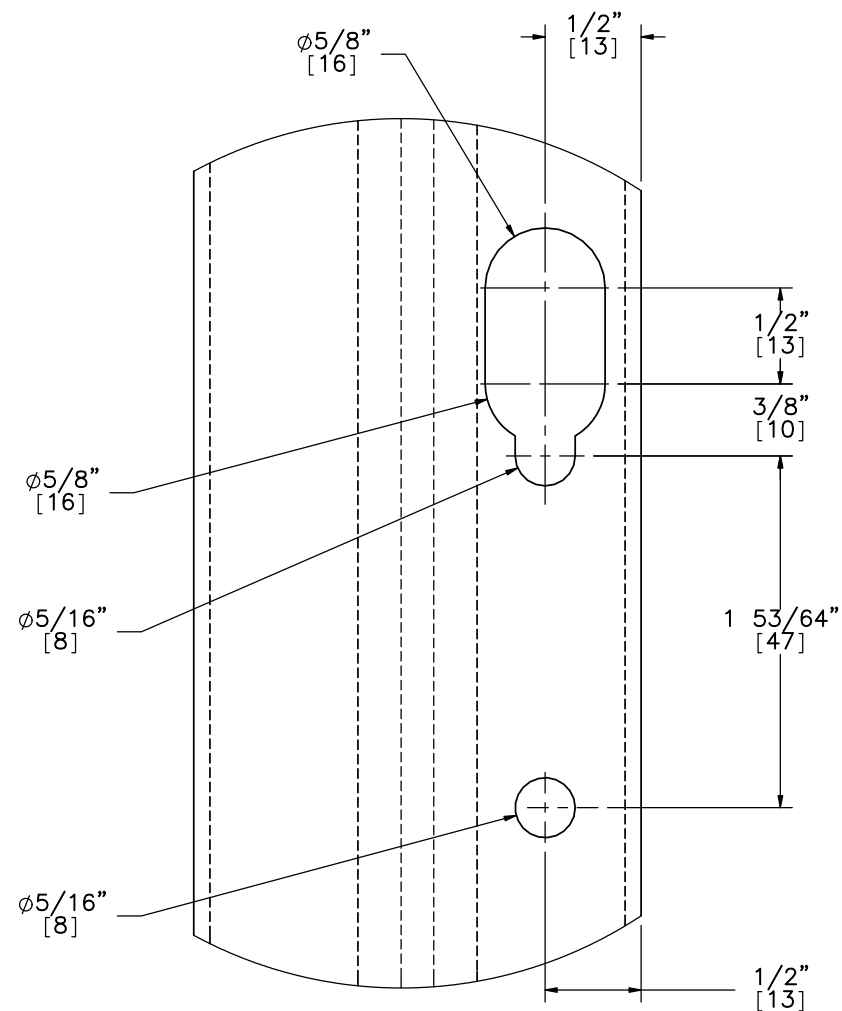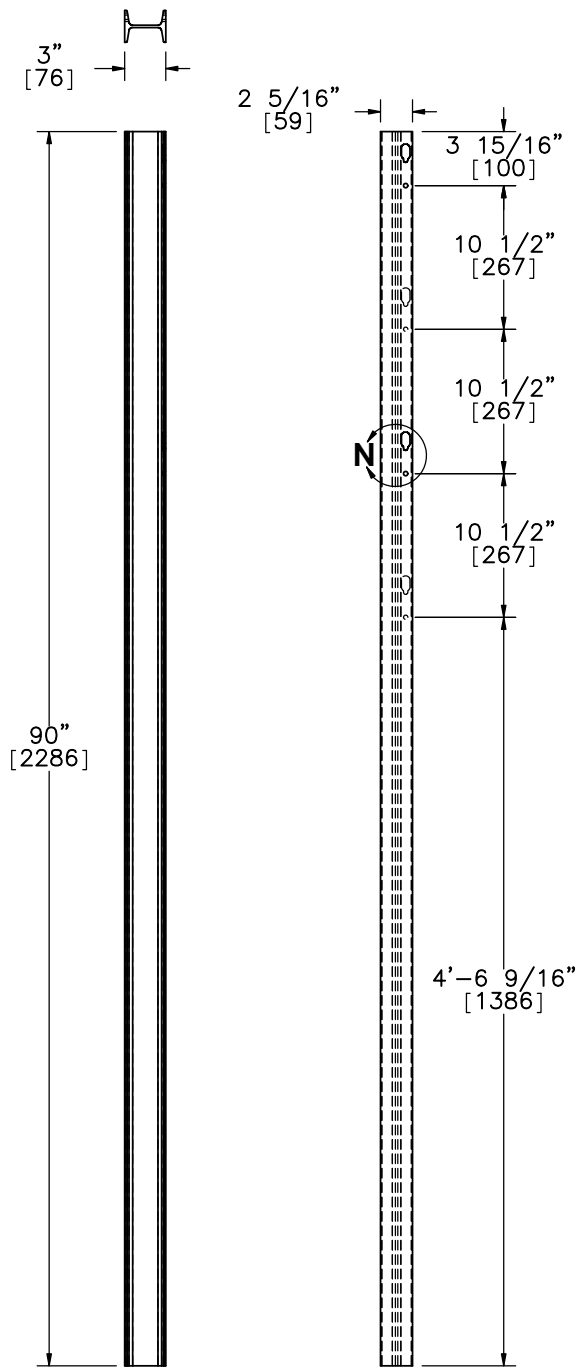

s3x57 90 in Post
Part c1




Midwest Roadside
Safety Facility

4-Cable Median Barrier
S3x5.7 90 in. Post

DWG. NAME.
4CMB-4_R9

SCALE: 1:14
UNITS: In.[mm]

SHEET:
17 of 23
DATE:
11/17/11
DRAWN BY:
MJW/MDM/
JGP
REV. BY:
KAL/CLM/
RWB

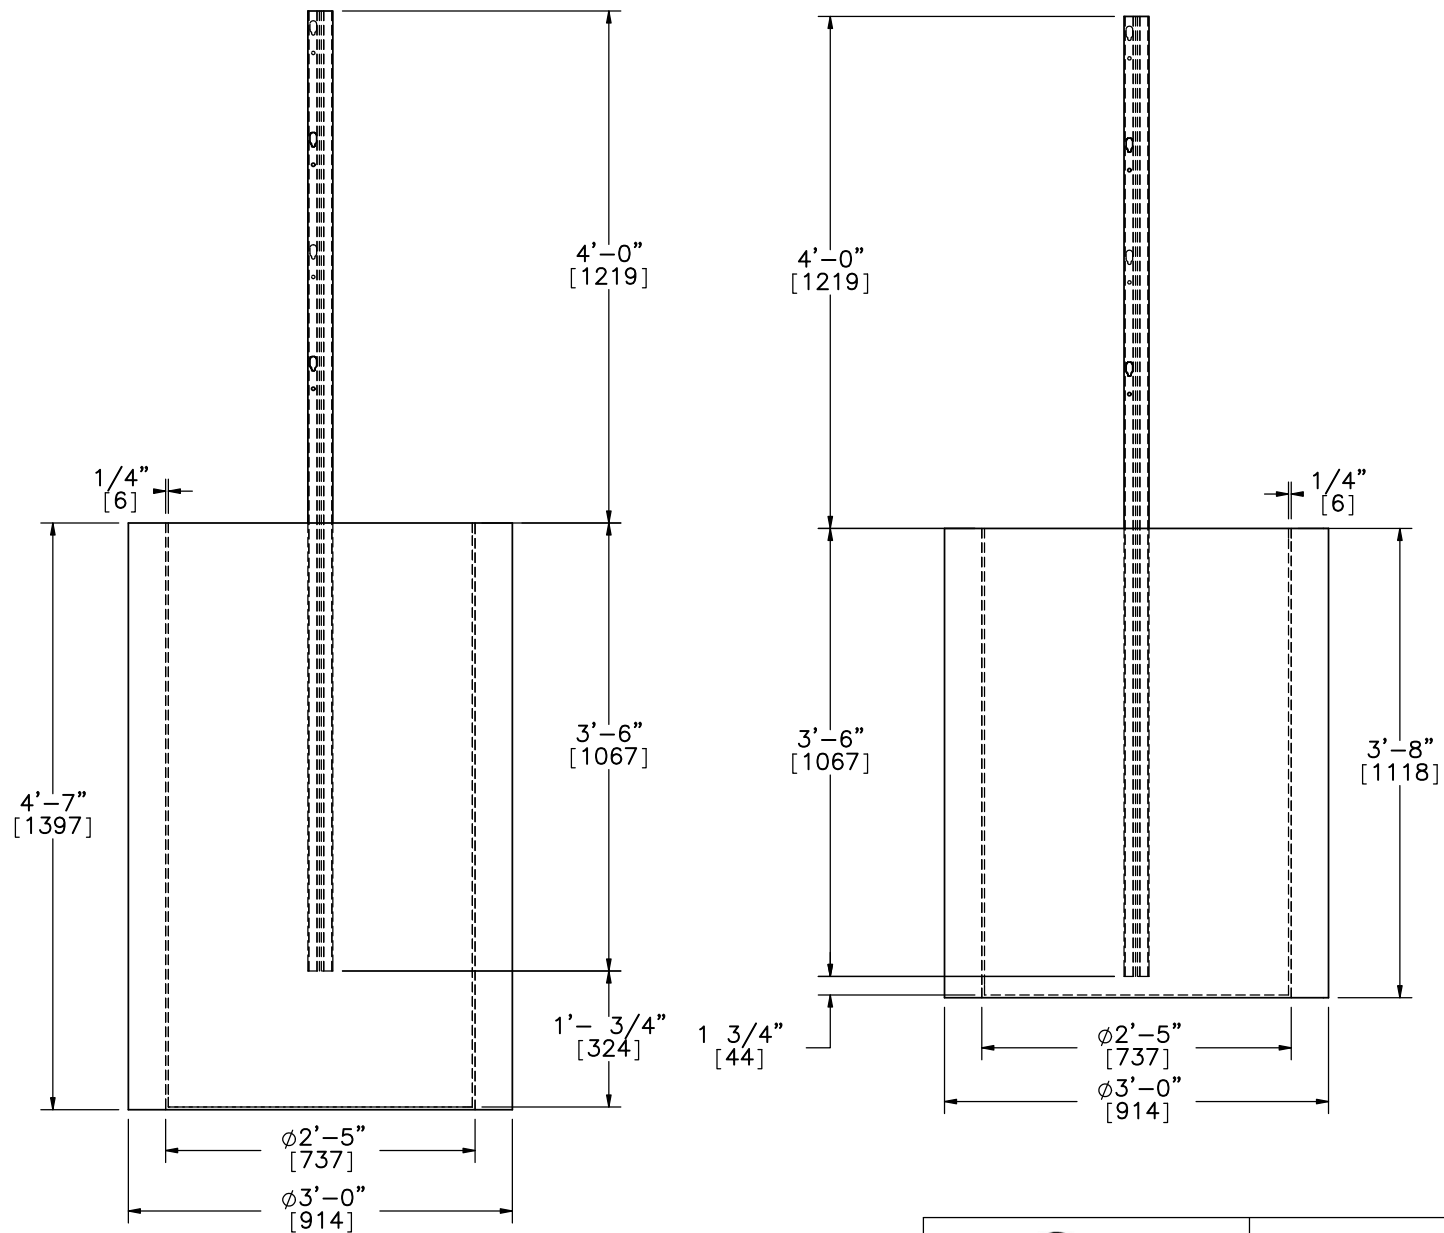


Midwest Roadside
Safety Facility

4-Cable Median Barrier
Post 15-24 Barrel Details

DWG. NAME.
4CMB-4_R9

SCALE: 1:18
UNITS: In.[mm]

SHEET:
18 of 23
DATE:
11/17/11
DRAWN BY:
MJW/MDM/
JGP
REV. BY:
KAL/CLM/
RWB

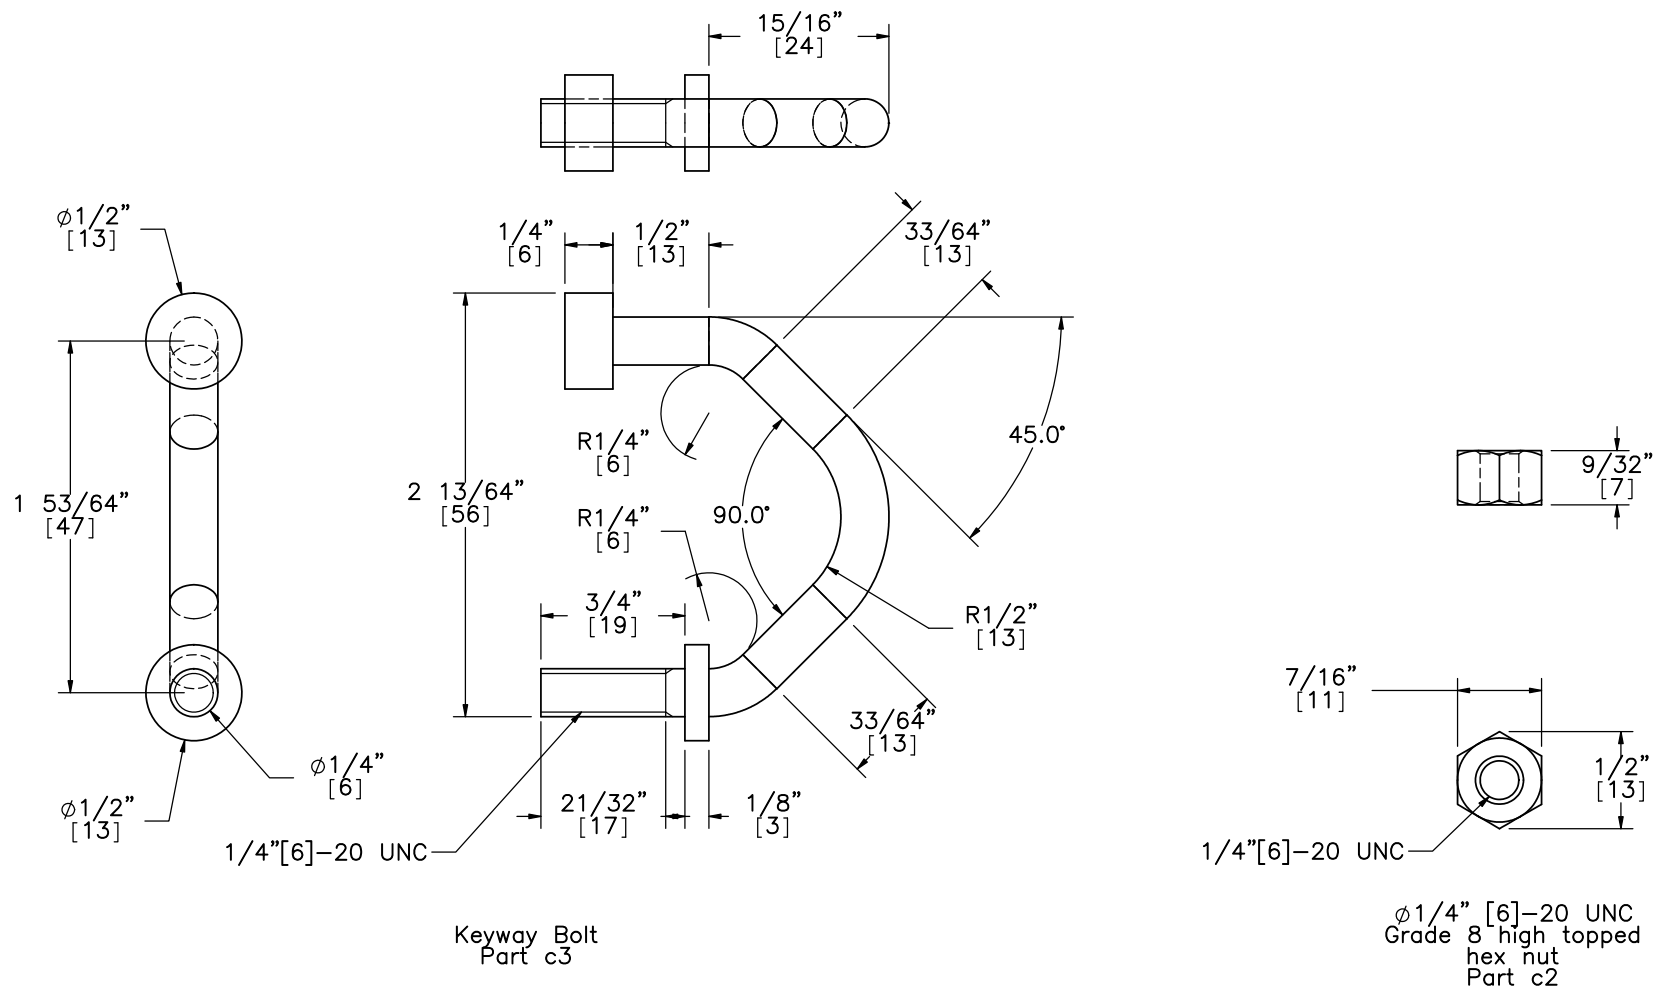

- NOTES: (1) A449 steel should be used to fabricate the custom keyway bolts. This material has a yield strength of 92 ksi [634 MPa], and ultimate strength of 120 ksi [827 MPa], and a 16% elongation to fracture.
- (2) Both the custom bolt and nut hardware are to be galvanized.



Midwest Roadside
Safety Facility

4-Cable Median Barrier
Keyway Bolt Details

DWG. NAME.
4CMB-4_R9


SCALE: 1:1
UNITS: In./mm

SHEET:
19 of 23

DATE:
11/17/11

DRAWN BY:
MJW/MDM/
JGP

REV. BY:
KAL/CLM/
RWB

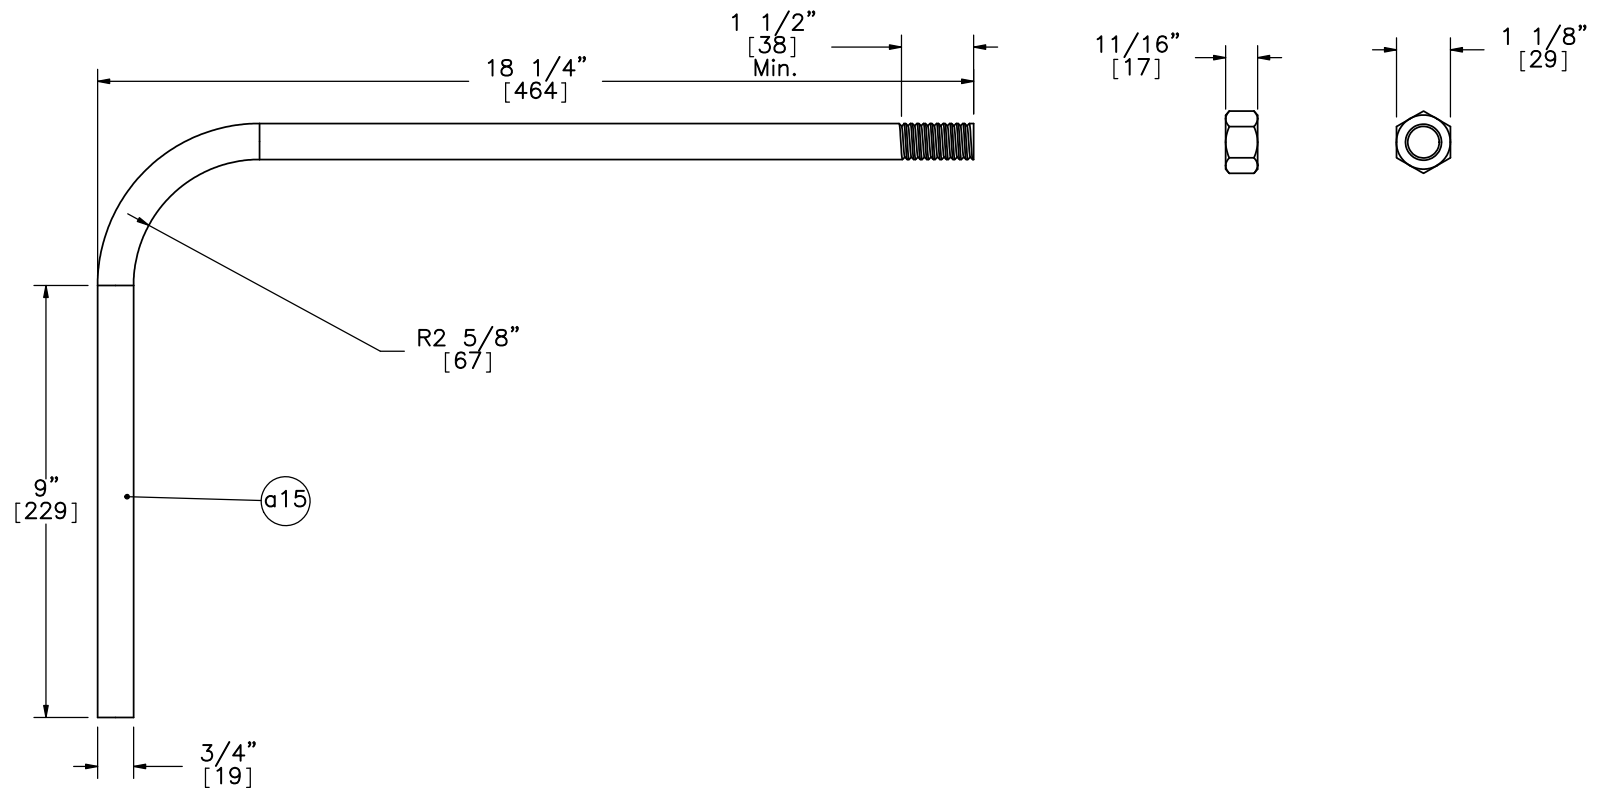

Note: (1) Total length is 28 9/16" [725].

(2) Outermost J-Hooks in anchor assembly were trimmed to fit inside reinforcement hoops.

	4-Cable Median Barrier		SHEET: 20 of 23
	J-Hook Anchor Stud and Nut – Part a15		DATE: 11/17/11
Midwest Roadside Safety Facility	DWG. NAME: 4CMB-4_R9		DRAWN BY: MJW/MDM/ JGP
	SCALE: 1:4 UNITS: In.[mm]		REV. BY: KAL/CLM/ RWB

Four Cable Median Barrier Bill of Materials					
Item No.	QTY.	Description	Material Spec	Hardware Guide	
a1	2	Cable Anchor Base Plate	A36 Steel	FPA02	
a2	4	Exterior Cable Plate Gusset	A36 Steel	FPA02	
a3	6	Interior Cable Plate Gusset	A36 Steel	FPA02	
a4	2	Anchor Bracket Plate	A36 Steel	FPA02	
a5	2	3/16" [5] Dia. Brass Keeper Rod, 14" [356] long	Brass	—	
a6	4	Release Gusset	A36 Steel	—	
a7	2	Release Lever Plate	A36 Steel	—	
a8	4	1.25x1.25x0.1875" [32x32x5] TS CT Kicker Lever Tube	ASTM A500 Grade B	—	
a9	8	CMB High Tension Anchor Plate Washer	A36 Steel	—	
a10	2	1.25x1.25x0.1875" [32x32x5] TS CT Kicker Lever Connecting Tube	ASTM A 500 Grade B	—	
a11	2	3x10x0.5" [76x254x13] Kicker Plate	A36 Steel	—	
a12	4	CT kicker — gusset	A36 Steel	—	
a13	20	3/4" [19] Dia. Flat Washer	Grade 2	FWC20a	
a15	16	3/4" Dia. J—Hook Anchor and Nut	A449	FRJ16a	
a16	2	1/4" [6] Dia. Aircraft Retaining Cable, 36" [914] long	7x19 galvanized	—	
a17	2	5/8" [16] Dia. Heavy Hex Nut	Grade 5	—	
a18	2	5/8" [16] Dia. x 9 1/2" [241] long Hex Bolt	Grade 5		
a19	2	24" [610] Dia. Concrete Anchor, 120" [3048] long	4,000 psi f'c	—	
a20	16	#11 Straight Rebar, 114" [2896] long	Grade 60	—	
a21	44	#4 Anchor Hoop Rebar with 21" [533] Dia.	Grade 60	—	
b1	2	S3x5.7 [S76x8.5] Post by 28 1/8" [714]	ASTM A572 GR50—07, ASTM A709 GR50—09A, ASTM A992—06A	—	
b2	2	S3x5.7 [S76x8.5] Post by 19" [483]	ASTM A572 GR50—07, ASTM A709 GR50—09A, ASTM A992—06A		
b3	8	#3 Straight Rebar, 43" [1092] long	Grade 60	—	
b4	22	7 1/4" [184] Dia. No. 3 Hoop Reinforcement	Grade 60	—	
b5	2	2nd Post Keeper Plate, 28 Gauge	A36	—	
b6	2	3/4" [19] Dia. x 6" [152] long Hex Bolt and Nut	A307	FBX20a	
b7	2	3/4" [19] Dia. Hex Nut	Grade 2	FNX20a	
b8	24	1/2" [13] Dia. Washer	A307	FWC14a	
b9	8	1/2" [13] Dia. x 2 1/2" [64] long Hex Bolt and Nut	A307	FBX14a	
b10	2	4x3x1/4" [102x76x6] Foundation Tube, 48" [1168] long	ASTM A500 Grade B	—	
b11	2	2nd Post Cable Hanger	A36	—	
b12	2	2nd Post Anchor Aggregate 12 in, Depth	—	—	
b13	2	12" [305] Dia. 2nd Post Concrete Anchor, 46" [1168] long	4,000 psi f'c	—	
b14	4	2nd Post Base Plate	A36	—	
c1	36	S3x5.7 [S76x8.5] by 90" [1524]	ASTM A572 GR50—07, ASTM A709 GR50—09A, ASTM A992—06A	—	
c2	144	1/4" [6] Dia. — 20 UNC Hex Nut High Topped	Grade 8 — Galvanized	—	
c3	144	1/4" [6] dia. Keyway bolt	A449 — Galvanized	—	
			4—Cable Median Barrier		SHEET: 21 of 23
			Bill of Materials		DATE: 11/17/11
		Midwest Roadside Safety Facility	DWG. NAME: 4CMB—4_R9	SCALE: None UNITS: In./mm	REV. BY: KAL/CLM/ RWB

Four Cable Median Barrier Bill of Materials Continued				
Item No.	QTY.	Description	Material Spec	Hardware Guide
d1	4	3/4" [19] Dia. High Strength Pre-Stretched Cable Guiderail	3x7 CI A Galvanized	RCM01
d2	16	7/8" [22] Dia. Hex Nut	A563	RCE03
d3	20	7/8" [22] Cable End Threaded Rod	ASTM-A449	RCE03
d4	16	Bennet Cable End Fitter	ASTM-A47	RCE03
d5	16	7/8" Dia. Square Nut	Grade 5	FNS20
d6	8	CMB Splice Cable Insert	Brass (unknown)	—
d7	8	CMB Splice Threaded Rope Connector	Steel (unknown)	—
d8	4	Bennet Cable End Fitter	Steel (unknown)	—
e1	4	Bennet Short Threaded Turnbuckle	Not Specified	—
e2	8	Threaded Loadcell Coupler	N/A	—
e3	4	50,000-lb Load Cell	N/A	—

	4-Cable Median Barrier Bill of Materials Continued		SHEET: 22 of 23
			DATE: 11/17/11
Midwest Roadside Safety Facility	DWG. NAME. 4CMB-4_R9	SCALE: None UNITS: In./mm	DRAWN BY: MJW/MDM/ JGP
			REV. BY: KAL/CLM/ RWB

Post no. (S to N)	Clip type	Upstream or Downstream	Post set in Plastic Container	4CMB-3 Post	Other Info	A449 Bolt Grade 8 Nut
1	na - anchor	na	no	yes	same anchor hardware from previous testing	no
2	na - breakaway hanger post	na	no	no	replaced due to damage from rod clip bogie testing	no
3	Keyway bolt type (current)	upstream	no	no	installed and fabricated for upstream location	no
4	Keyway bolt type (current)	upstream	no	no	installed and fabricated for upstream location	no
5	Keyway bolt type (current)	upstream	no	no	installed and fabricated for upstream location	no
6	Keyway bolt type (current)	upstream	no	no	installed and fabricated for upstream location	no
7	Keyway bolt type (current)	upstream	no	no	installed and fabricated for upstream location	no
8	Keyway bolt type (current)	upstream	no	no	installed and fabricated for upstream location	no
9	Keyway bolt type (current)	upstream	no	no	installed and fabricated for upstream location	no
10	Keyway bolt type (current)	upstream	no	no	installed and fabricated for upstream location	no
11	Keyway bolt type (current)	upstream	no	no	installed and fabricated for upstream location	no
12	Keyway bolt type (current)	upstream	no	no	installed and fabricated for upstream location	yes
29	Keyway bolt type (current)	upstream	no	no	installed and fabricated for upstream location	no
30	bracket type clip	downstream	no	yes	4cmb-3 post	no
31	bracket type clip	downstream	no	yes	4cmb-3 post	no
32	bracket type clip	downstream	no	yes	4cmb-3 post	no
33	bracket type clip	downstream	no	yes	4cmb-3 post	no
34	bracket type clip	downstream	no	yes	4cmb-3 post	no
35	j-bolt - ran out of brackets	downstream	no	yes	4cmb-3 post	no
36	j-bolt - ran out of brackets	downstream	no	yes	4cmb-3 post	no
37	j-bolt - ran out of brackets	downstream	no	yes	4cmb-3 post	no
38	j-bolt - ran out of brackets	downstream	no	yes	4cmb-3 post	no
39	na - breakaway hanger post	na	no	yes	4cmb-3 post	no
40	na - anchor	na	no	yes	4cmb-3 post	no



4-Cable Median Barrier

Layout Info

SCALE: None
UNITS: In [mm]