


PLAN VIEW

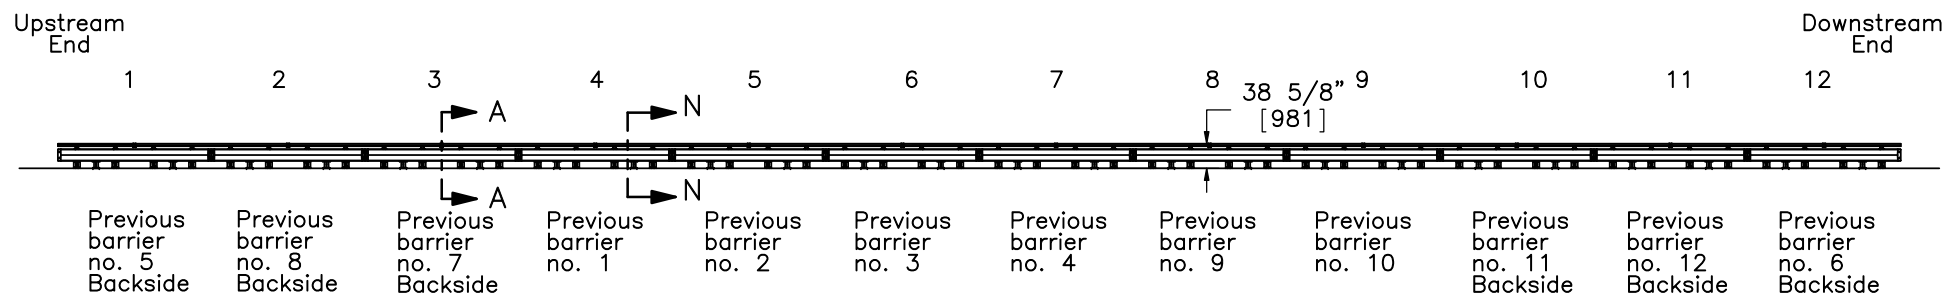

ELEVATION VIEW

- Notes: (1) Impact location is 60" [1524] upstream of joint between barrier nos. 5 and 6.
- (2) Overall nominal height of barrier may decrease once assembled due to the weight of the rail on rubber.
- (3) Mark existing damage from test nos. SFH-1 and SFH-2.
- (4) Move damaged posts to the US end of the system.
- (5) The barriers with contact marks (5, 6, 7, 8, 11, 12) should be rotated so that the previous backside of the barrier will be impacted.



SAFER For Highway -
Angle Joint (SFH-3)

System Layout

DWG. NAME.
SFH-3_AJ_R3



SCALE: 1:300
UNITS: in.[mm]

SHEET:
1 of 23

DATE:
10/16/2014

DRAWN BY:
JEK/SDB

REV. BY:
JDS/SKR/
KAL

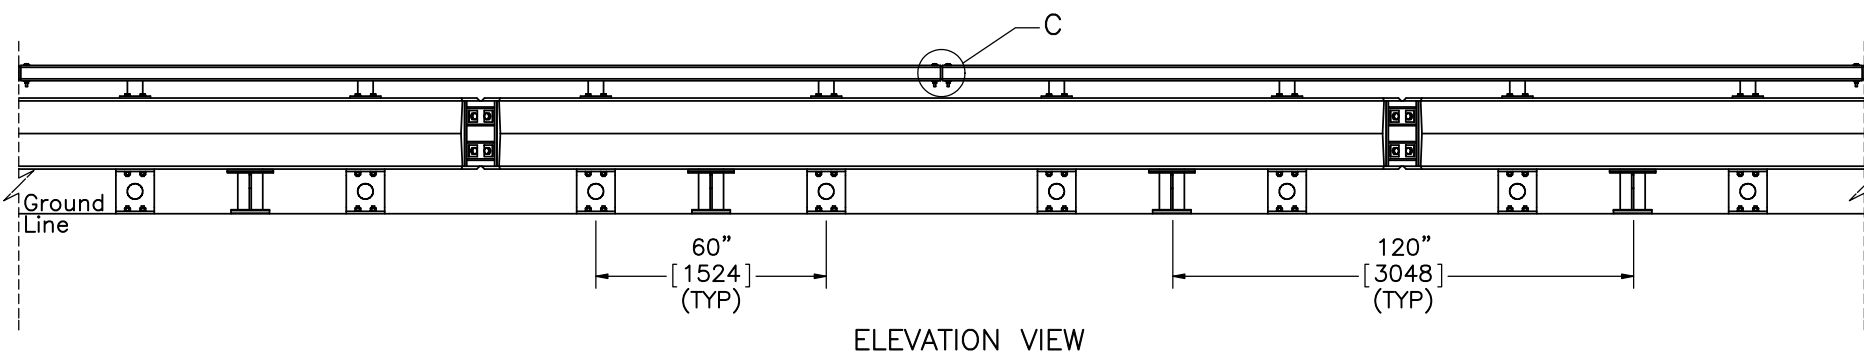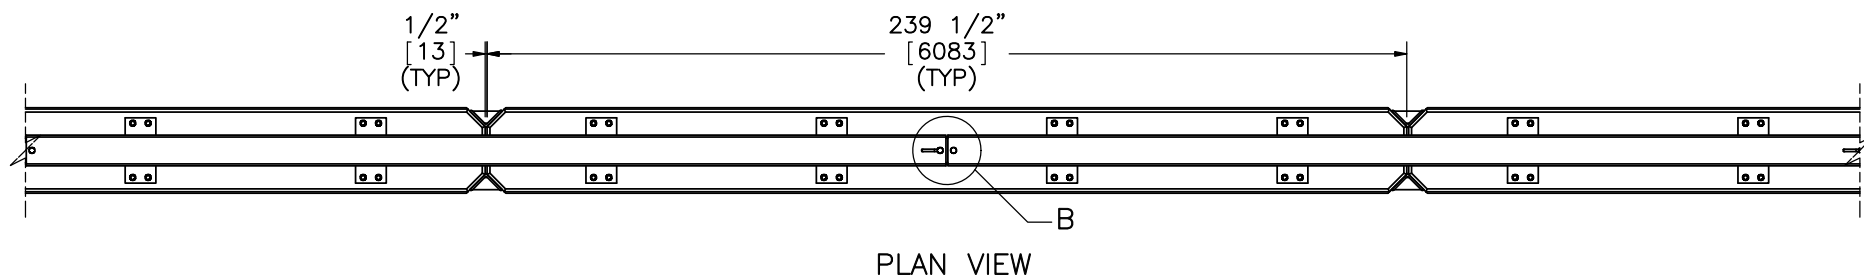

Midwest Roadside
Safety Facility

SAFER For Highway -
Angle Joint (SFH-3)

Barrier Assembly

DWG. NAME.
SFH-3_AJ_R3


SCALE: 1:50
UNITS: in./mm

SHEET:
2 of 23

DATE:
10/16/2014


DRAWN BY:
JEK/SDB

REV. BY:
JDS/SKR/
KAL

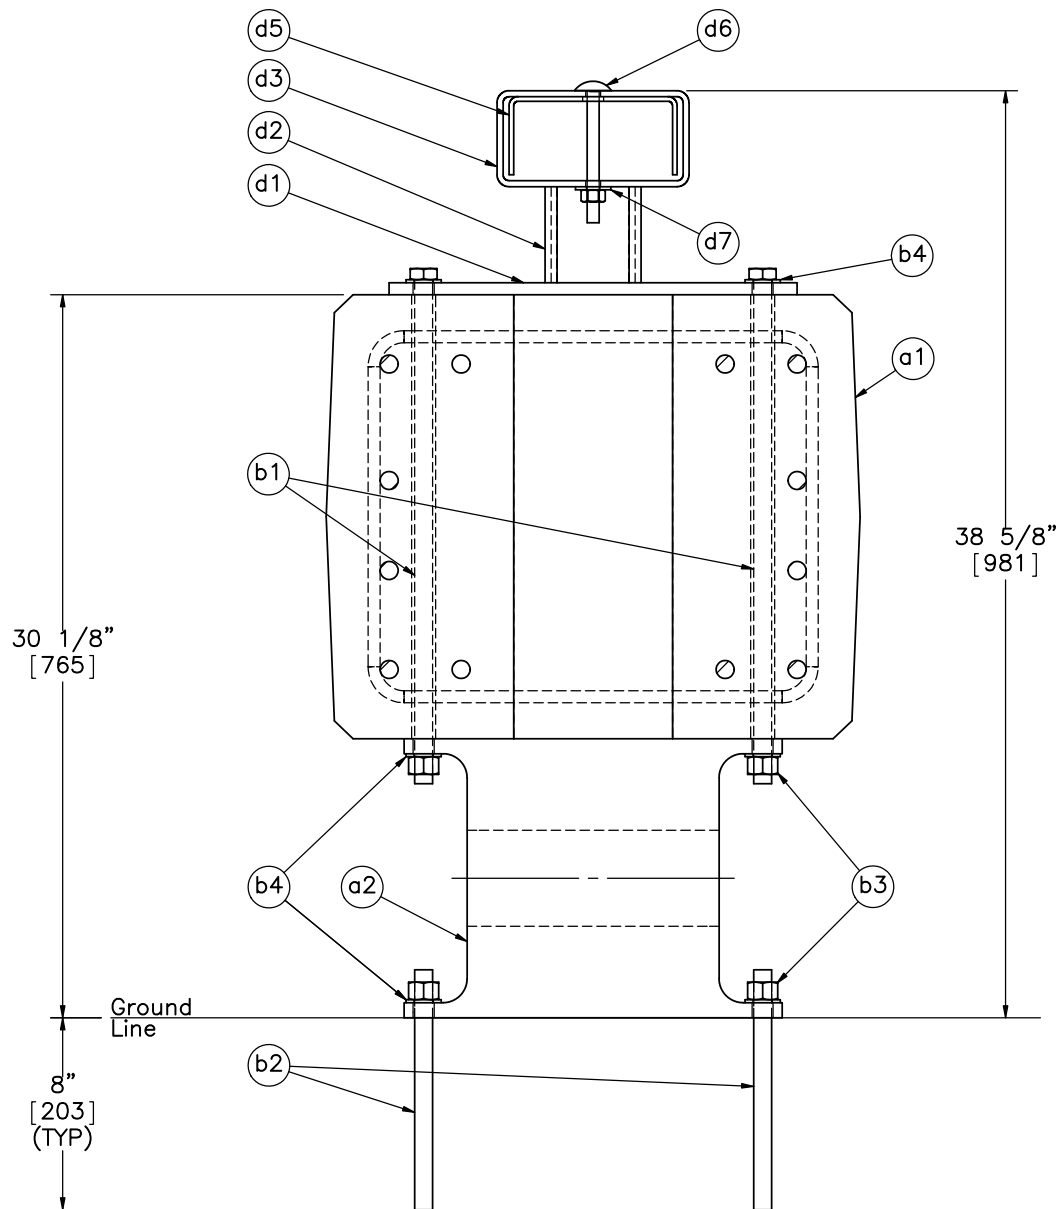


SECTION A-A

Notes: (1) Anchor part b2 into tarmac with HILTI HIT-RE500 epoxy.

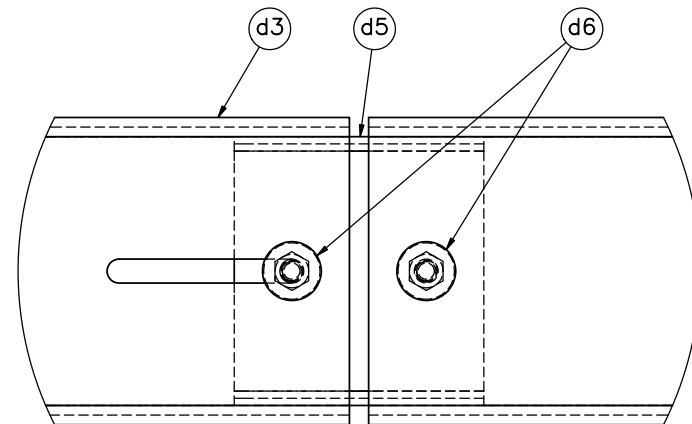

DETAIL B
SCALE 1 : 5

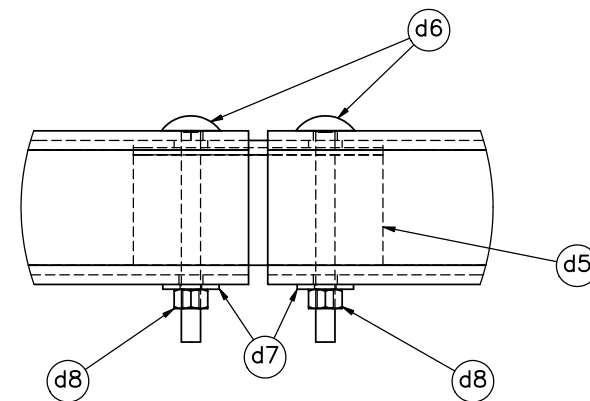

DETAIL C
SCALE 1 : 5



Midwest Roadside
Safety Facility


SAFER For Highway -
Angle Joint (SFH-3)

Post and Tubing Details


DWG. NAME.
SFH-3_AJ_R3

SCALE: 1:8
UNITS: in./mm

SHEET:
3 of 23
DATE:
10/16/2014
DRAWN BY:
JEK/SDB
REV. BY:
JDS/SKR/
KAL

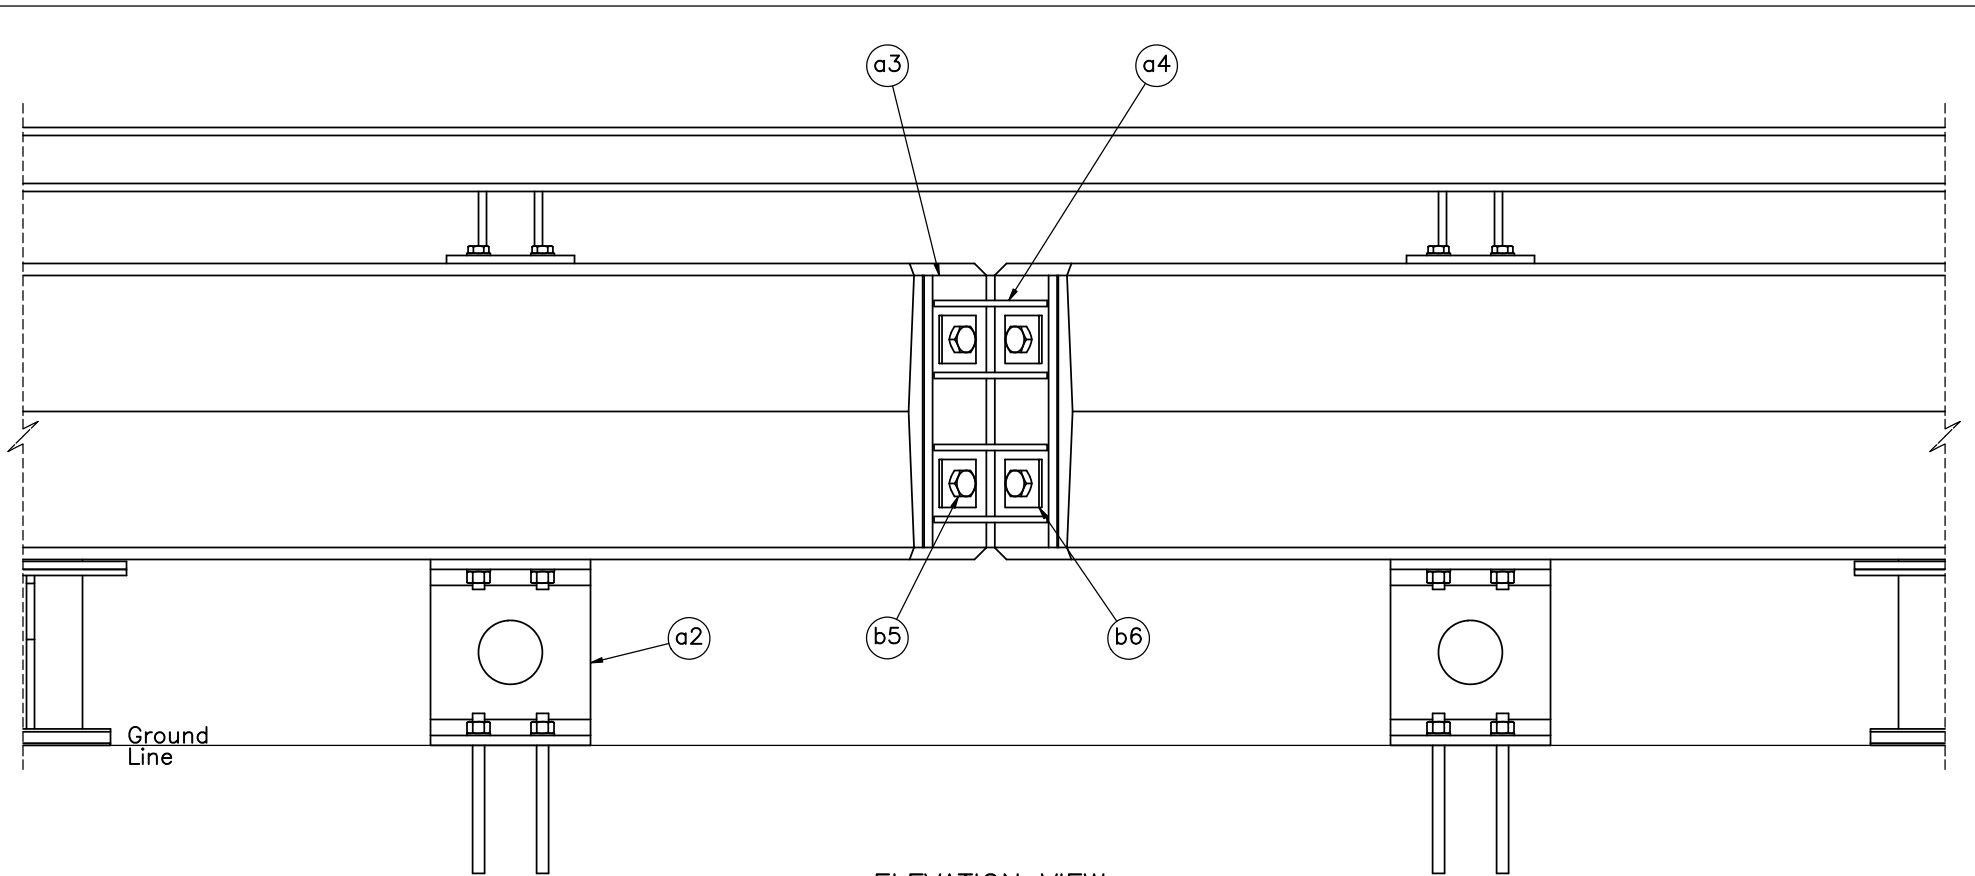


ELEVATION VIEW
SPICE DETAIL

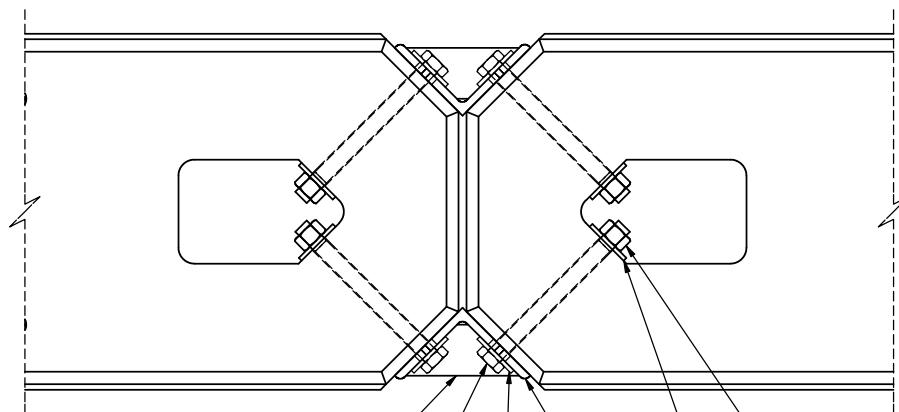

PLAN VIEW
SPICE DETAIL

Notes: (1) Rebar, top steel tube assembly, and shear fenders removed from Plan View.

	SAFER For Highway – Angle Joint (SFH-3)		SHEET: 4 of 23
	Splice Details		DATE: 10/16/2014
Midwest Roadside Safety Facility	DWG. NAME: SFH-3_AJ_R3		DRAWN BY: JEK/SDB
	SCALE: 1:12 UNITS: in./mm		REV. BY: JDS/SKR/ KAL

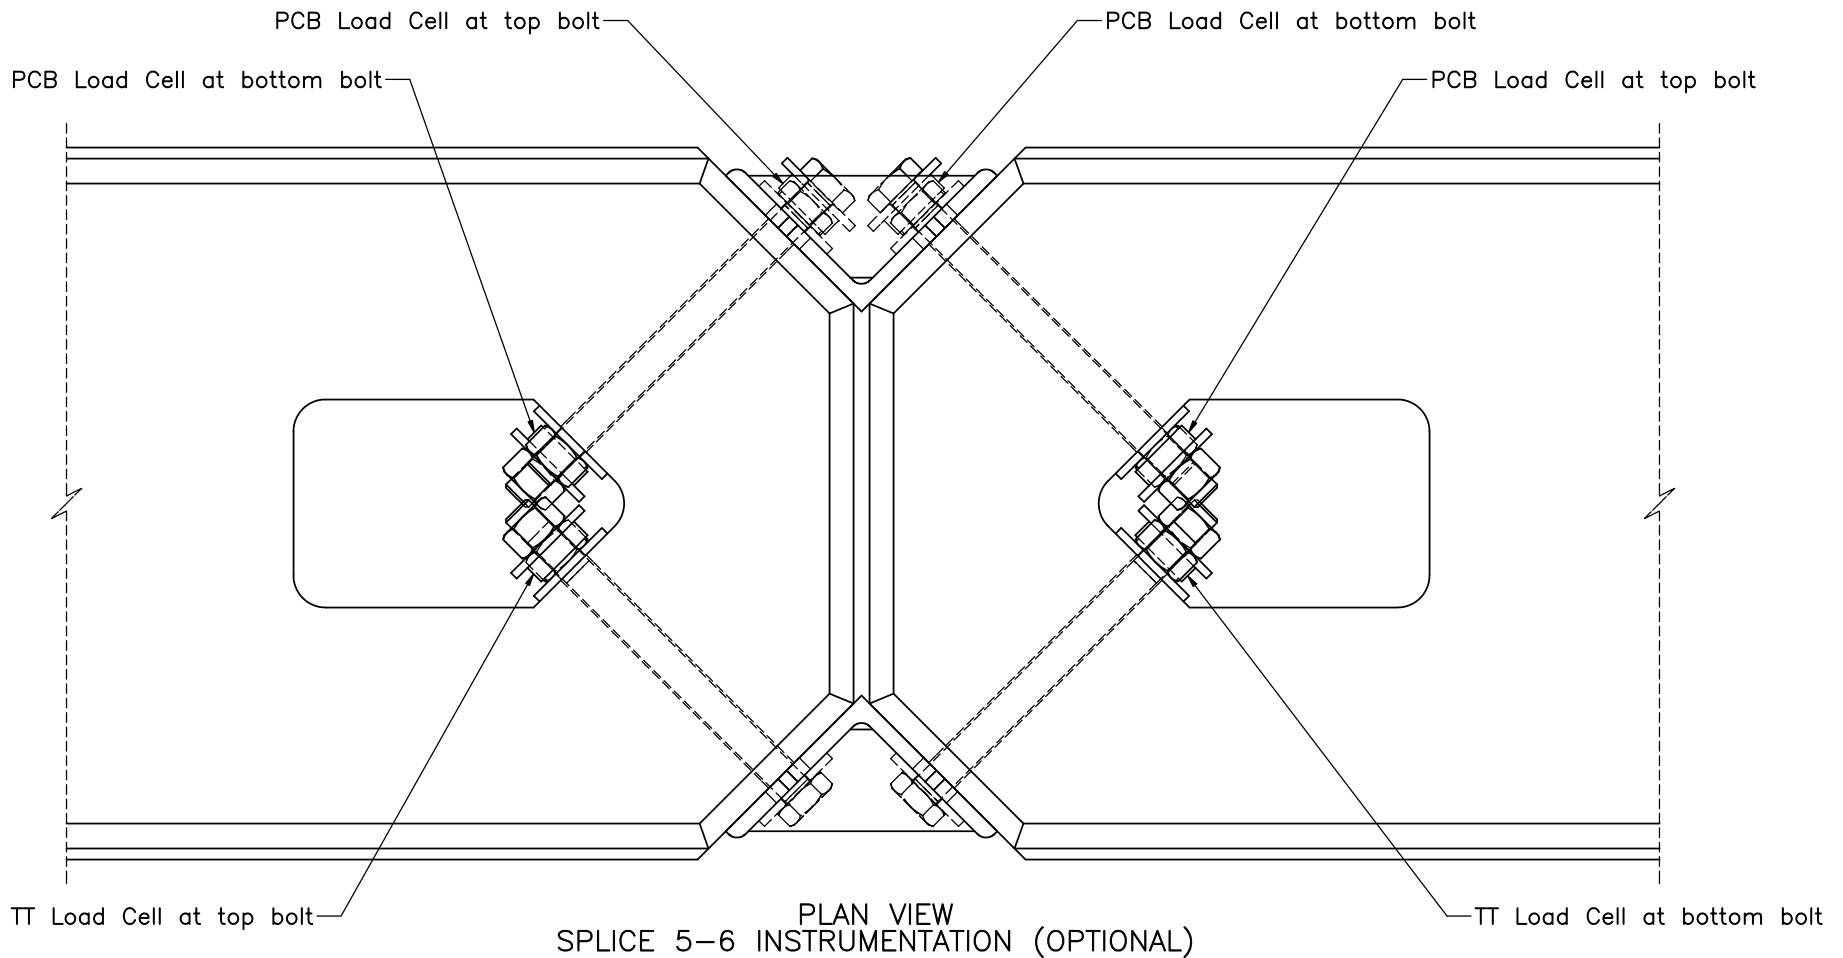

Notes: (1) Rebar, top steel tube assembly, and shear fenders removed from Plan View.

(2) PCB Piezotronics 206C (PCB)
2.00" O.D.
1.024" I.D.
0.500" thickness

(3) Transducer Technique LW0-80 (TT)
2.05" O.D.
1.025" I.D.
0.610" thickness

(4) Use additional 3"x3"x1/4" [76x76x6] plate washer if available to sandwich load cell.

(5) Anti-friction washer provided by PCB is optional.



Midwest Roadside
Safety Facility

SAFER For Highway –
Angle Joint (SFH-3)

Splice 5-6 Instrumentation
Details

DWG. NAME:
SFH-3_AJ_R3


SCALE: 1:6
UNITS: in./mm

SHEET:
5 of 23

DATE:
10/16/2014

DRAWN BY:
JEK/SDB

REV. BY:
JDS/SKR/
KAL

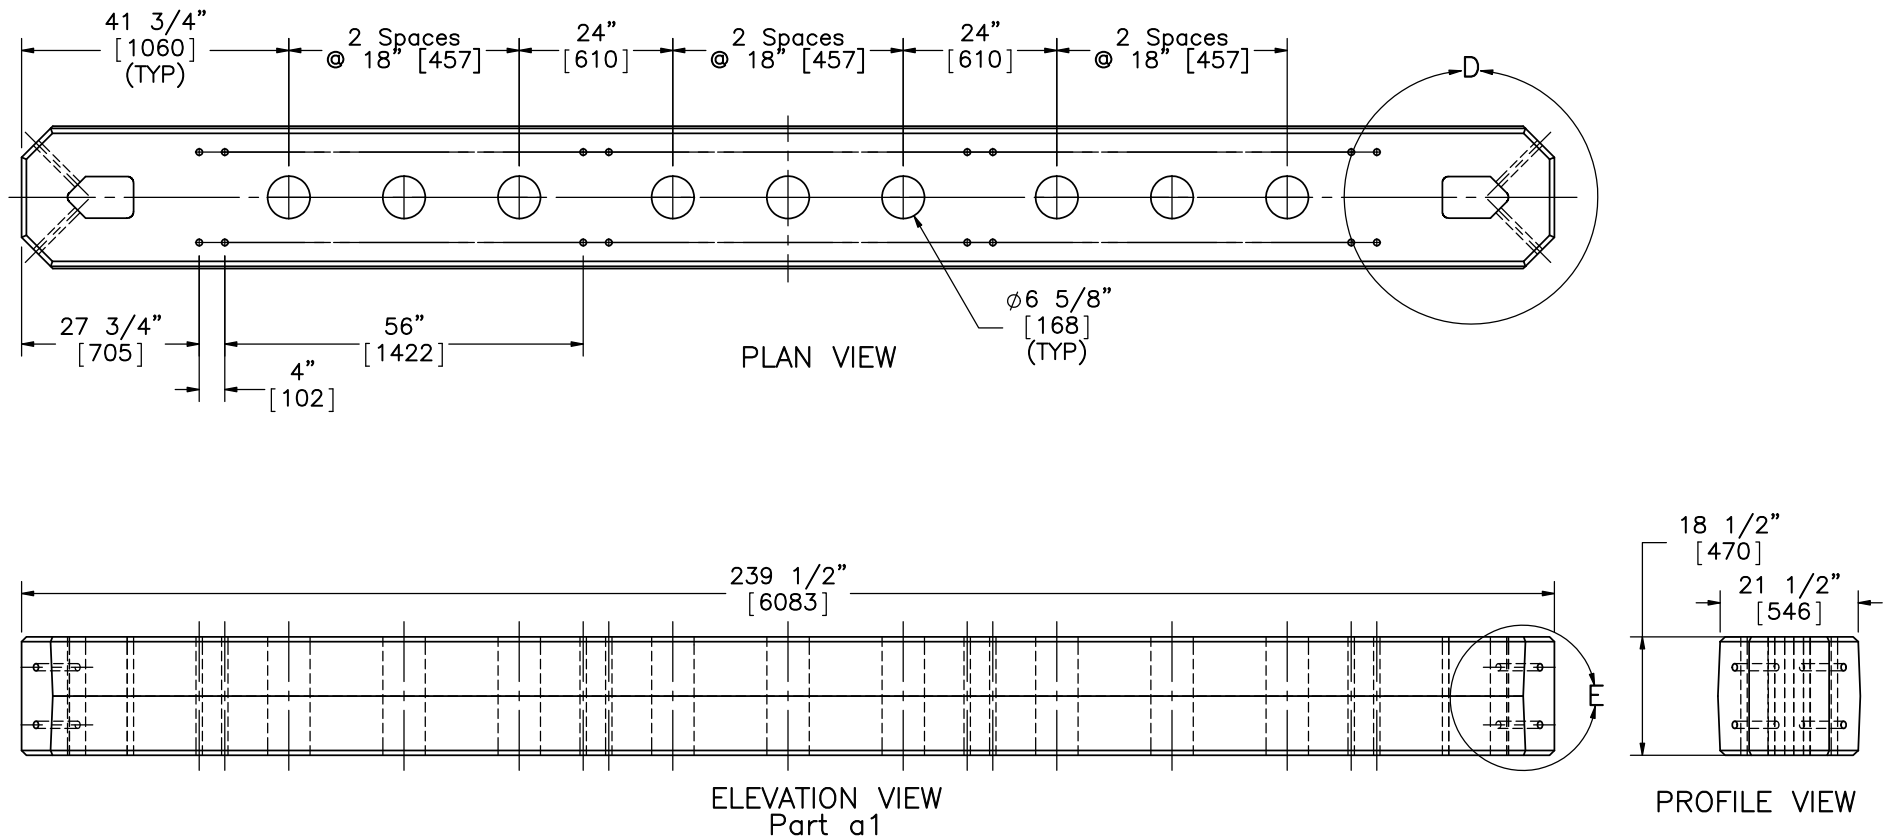

- Notes: (1) The $\phi 6 \frac{5}{8}"$ [168] through hole can be cast around a $\phi 6"$ [152] PVC pipe and then the pipe can later be removed.
- (2) The 3 surfaces at each end of the barrier must be vertical – front and back of rail drafted for casting purposes.
- (3) Internal Reinforcement not shown.
- (4) See as-built drawings from concrete industries for accurate rebar placement and more details.



Midwest Roadside
Safety Facility

SAFER For Highway –
Angle Joint (SFH-3)

Concrete Rail Geometry

DWG. NAME.
SFH-3_AJ_R3



SCALE: 1:30
UNITS: in./mm

SHEET:
6 of 23

DATE:
10/16/2014

DRAWN BY:
JEK/SDB

REV. BY:
JDS/SKR/
KAL

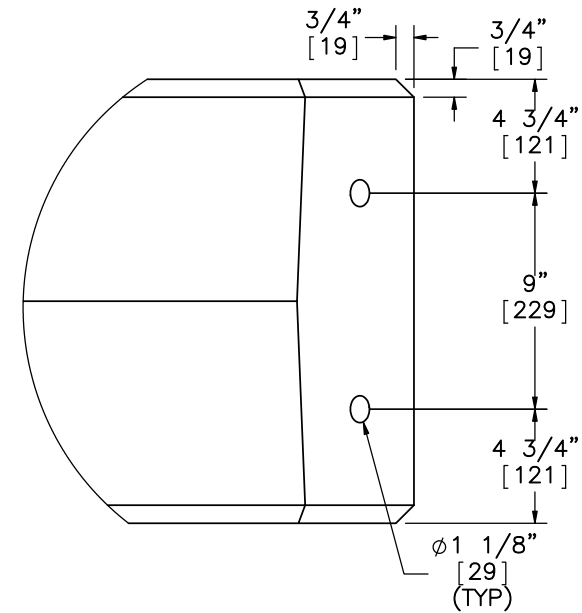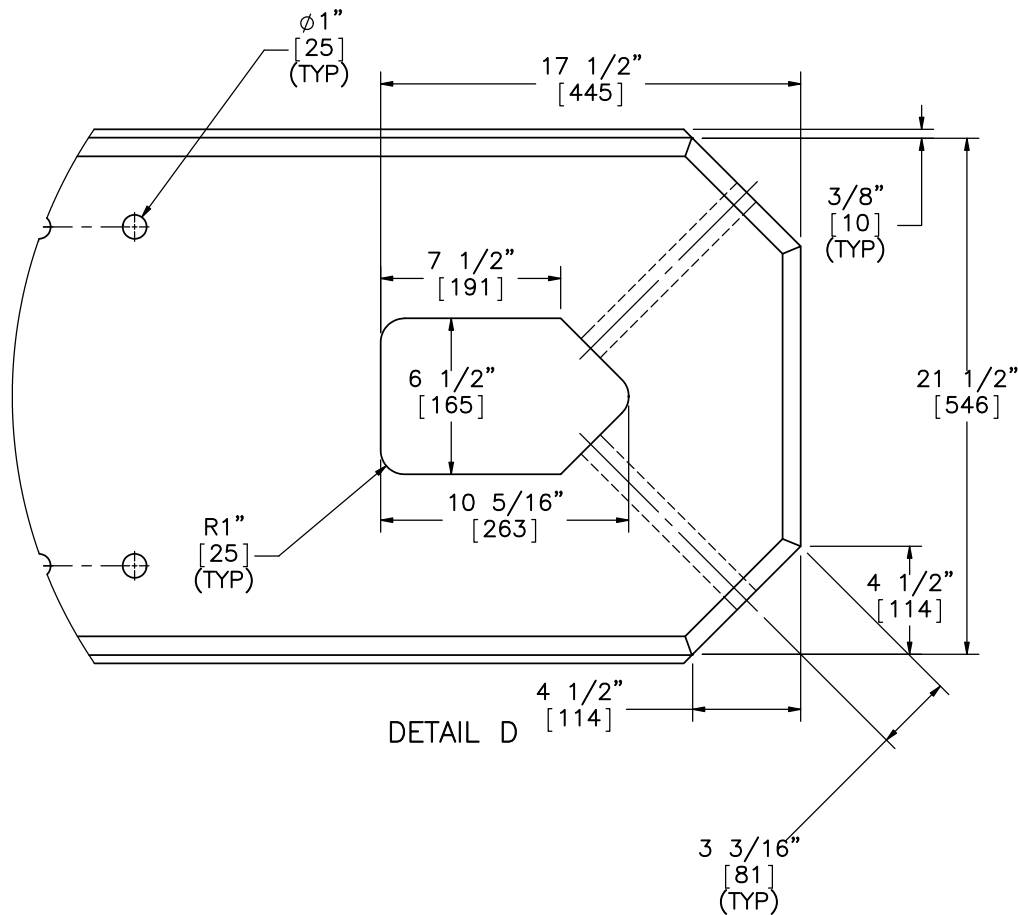

DETAIL D

DETAIL E

- Notes:
- (1) $\phi 1"$ [25] and $\phi 1 \frac{1}{8}"$ [29] through holes can be cast with or without an insert left in the beam.
 - (2) The "house-shaped" through hole can be case around an insert and then the insert can be removed; the radii can be varied if needed.
 - (3) The 3 surfaces at each end of the barrier must be vertical – front and back of rail drafted for casting purposes.
 - (4) $\phi 1 \frac{1}{8}"$ [29] holes to be centered on $4 \frac{1}{2}" \times 4 \frac{1}{2}"$ [114x114] chamfer.
 - (5) Internal reinforcement not shown.
 - (6) See as-built drawings from concrete industries for accurate rebar placement and more details.



Midwest Roadside
Safety Facility


SAFER For Highway –
Angle Joint (SFH-3)

Concrete Rail Details


DWG. NAME.
SFH-3_AJ_R3

SCALE: 1:8
UNITS: in.[mm]


SHEET:
7 of 23
DATE:
10/16/2014
DRAWN BY:
JEK/SDB
REV. BY:
JDS/SKR/
KAL

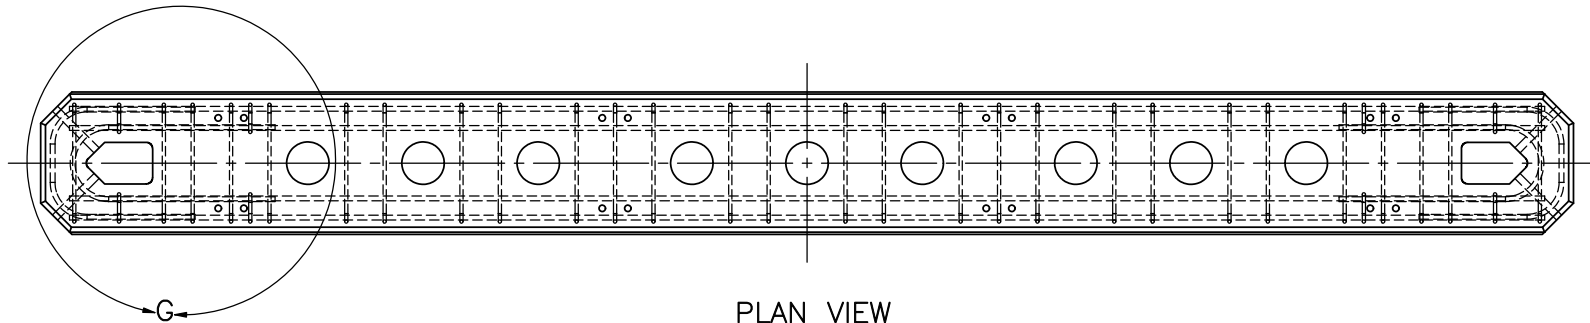

PLAN VIEW

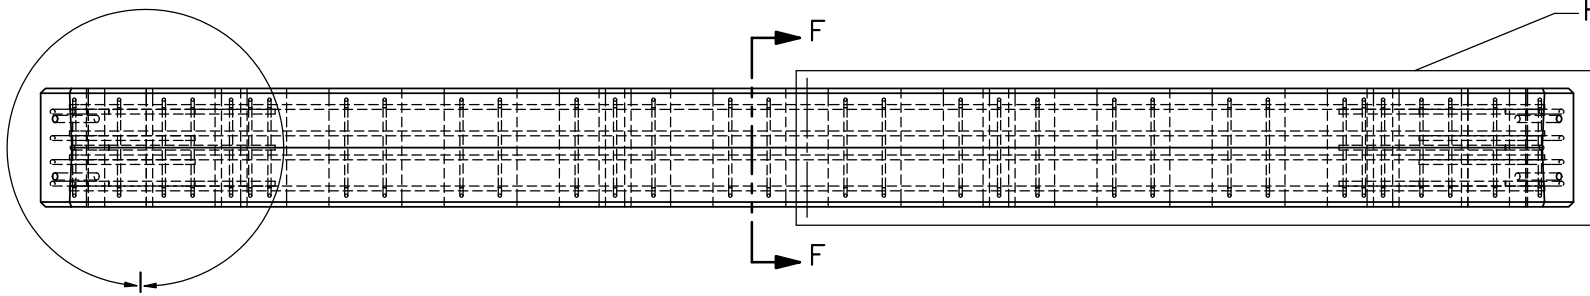

ELEVATION VIEW

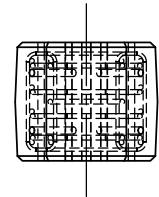

PROFILE VIEW

Notes: (1) Two single flared coil loop inserts (not shown) were added to each barrier segment.



Midwest Roadside
Safety Facility

SAFER For Highway –
Angle Joint (SFH-3)

Concrete Rail and Rebar
Assembly

DWG. NAME:
SFH-3_AJ_R3


SCALE: 1:30
UNITS: in.[mm]

SHEET:
8 of 23

DATE:
10/16/2014


DRAWN BY:
JEK/SDB

REV. BY:
JDS/SKR/
KAL

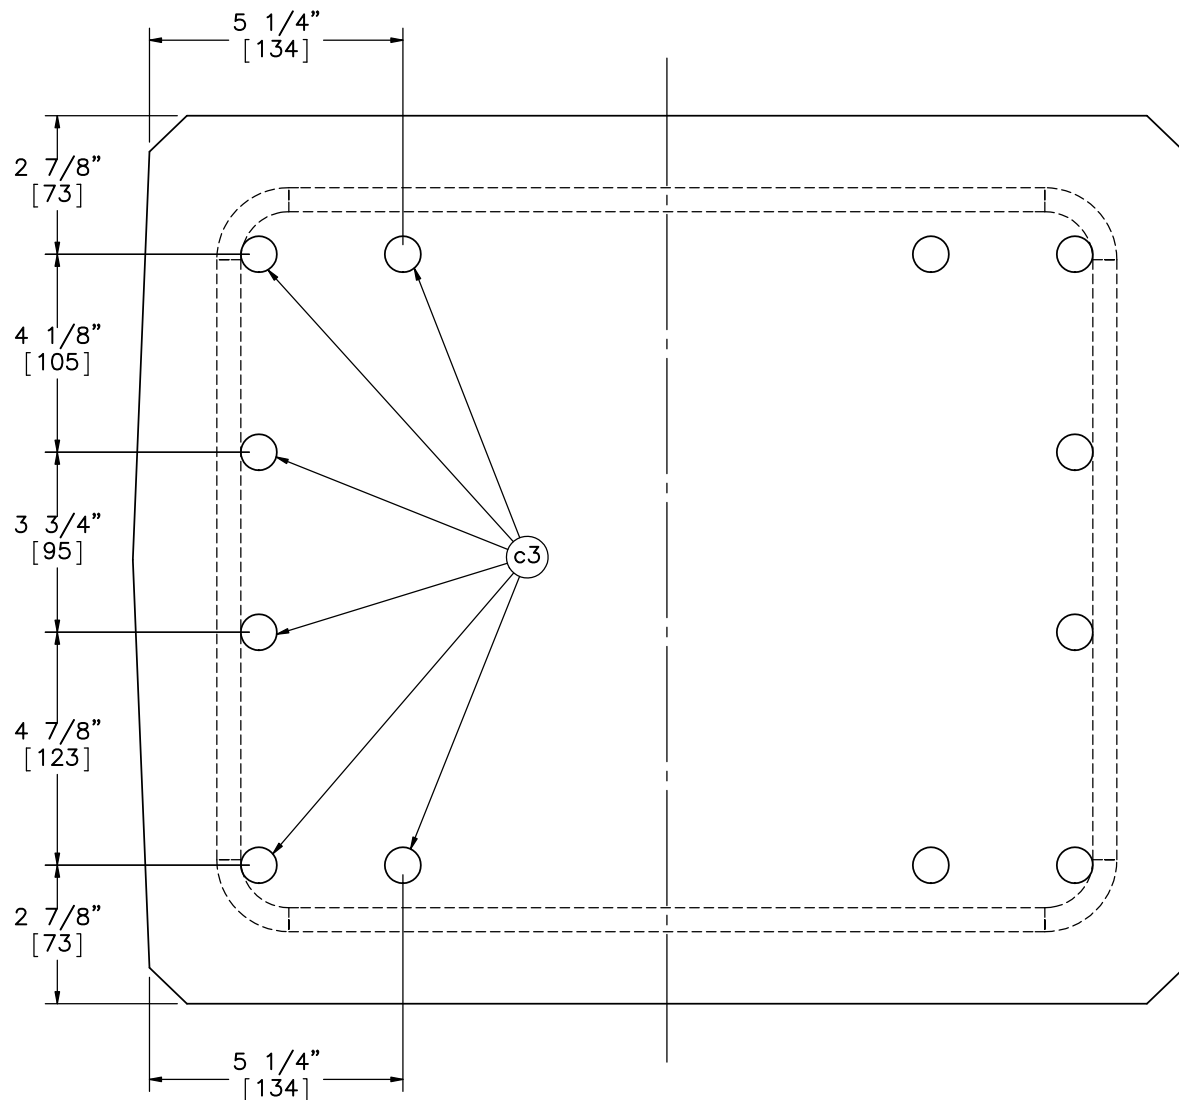


SECTION F-F

	SAFER For Highway – Angle Joint (SFH-3)		SHEET: 9 of 23
	Concrete Rail – Rebar Assembly Details		DATE: 10/16/2014
Midwest Roadside Safety Facility	DWG. NAME: SFH-3_AJ_R3		DRAWN BY: JEK/SDB
	SCALE: 1:4 UNITS: in.[mm]		REV. BY: JDS/SKR/KAL

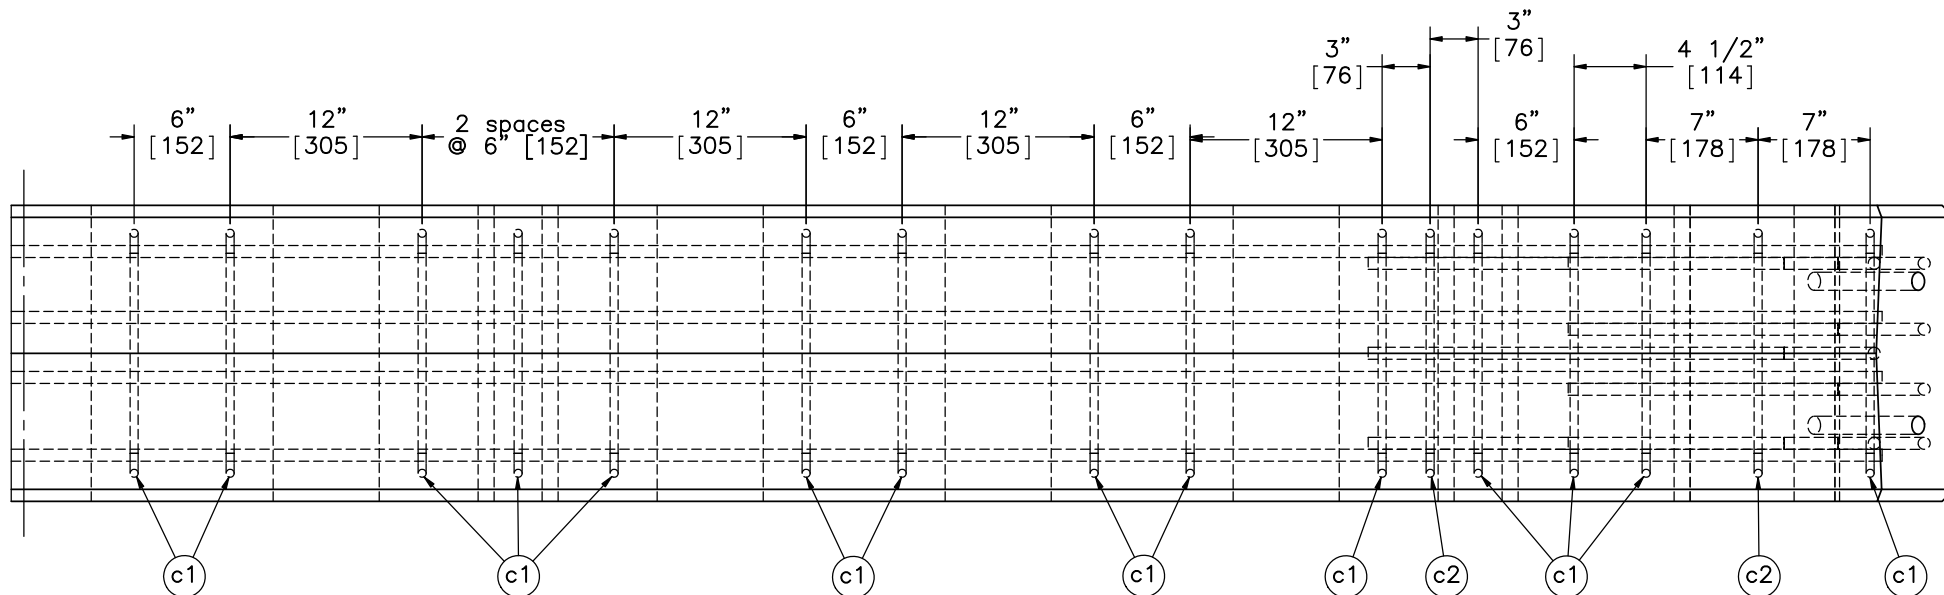

DETAIL H

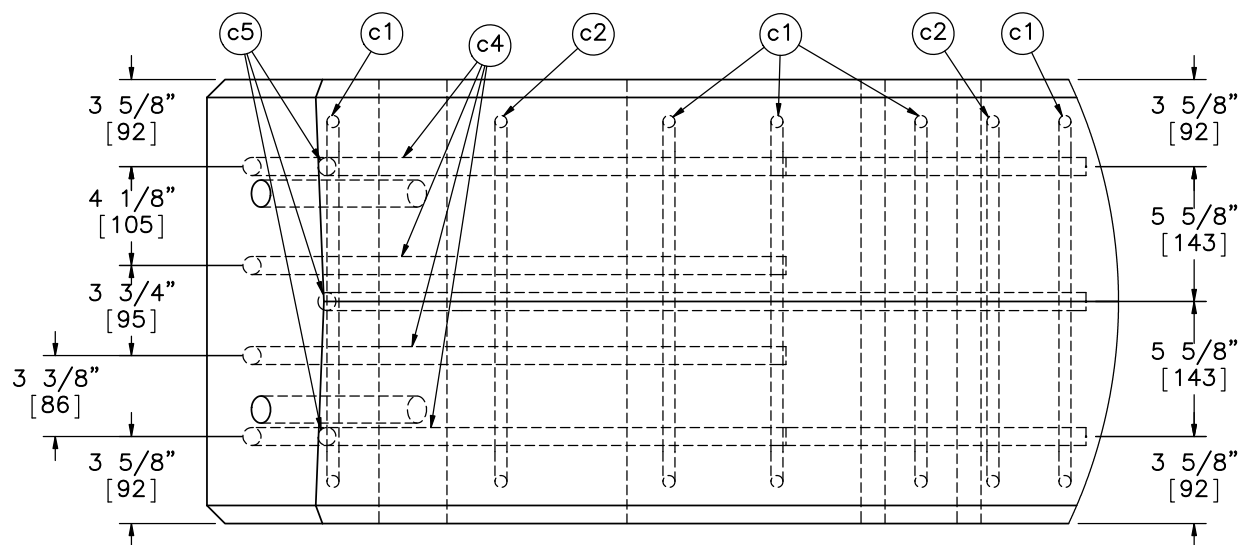

DETAIL I
SCALE 1 : 8

- Notes: (1) Longitudinal Rebar, Part c3 removed from Detail I for clarity.
(2) Place top and bottom c4 and c5 bars adjacent to longitudinal c3 bars.



Midwest Roadside
Safety Facility

SAFER For Highway -
Angle Joint (SFH-3)

Concrete Rail - Rebar
Assembly Details

DWG. NAME:
SFH-3_AJ_R3


SCALE: 1:12
UNITS: in.[mm]

SHEET:
11 of 23

DATE:
10/16/2014

DRAWN BY:
JEK/SDB

REV. BY:
JDS/SKR/
KAL

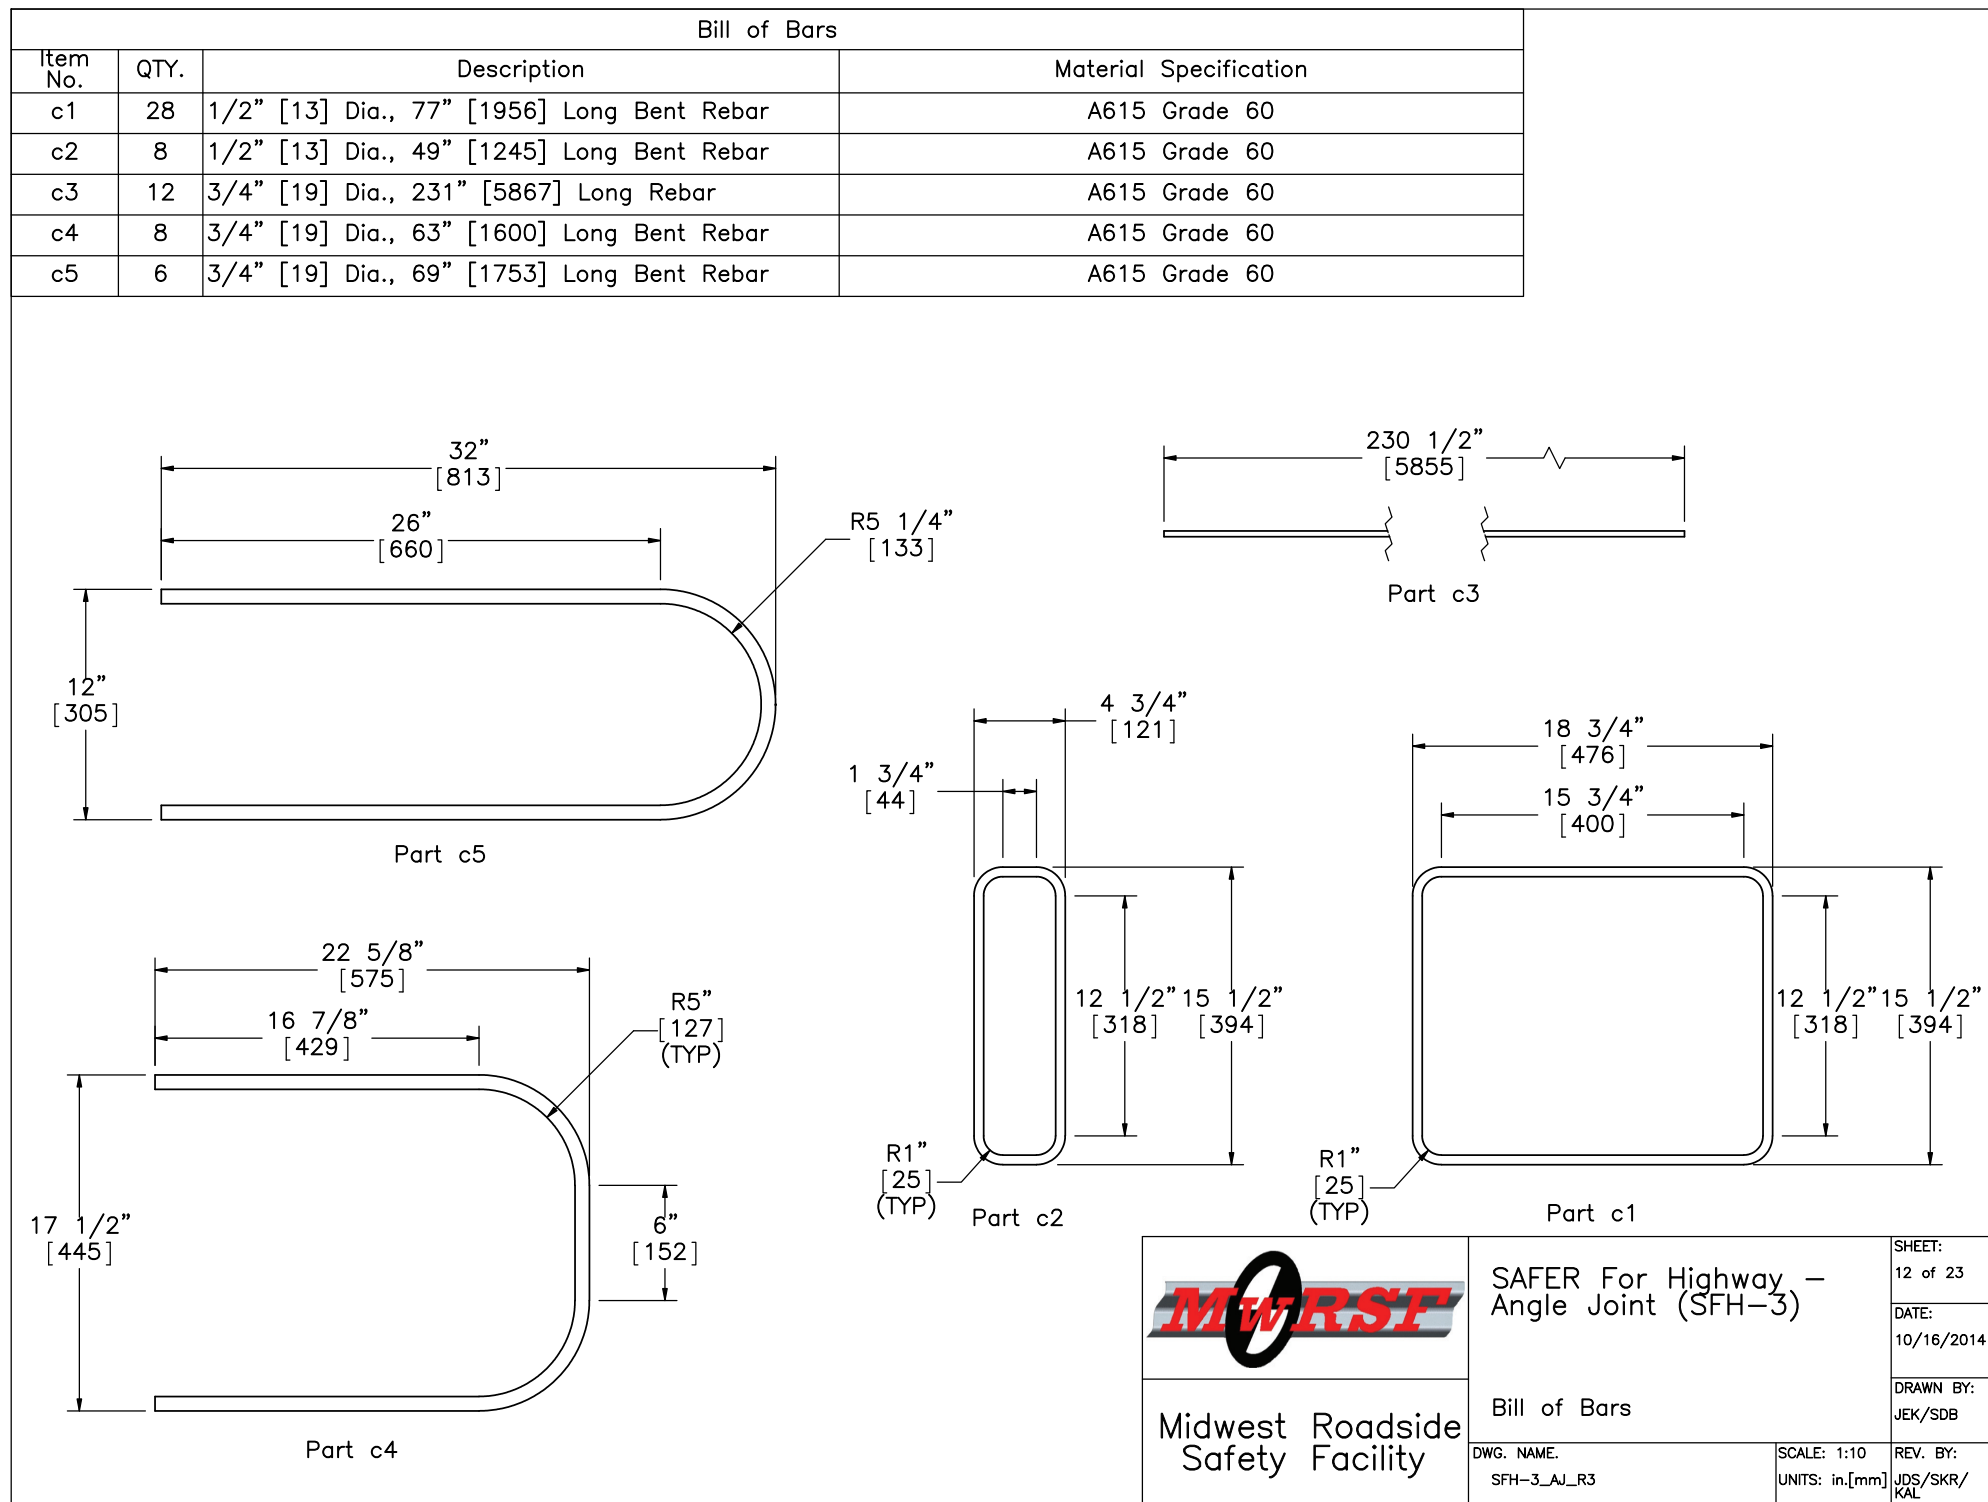

Midwest Roadside
Safety Facility


SAFER For Highway –
Angle Joint (SFH-3)

Bill of Bars

DWG. NAME.
SFH-3_AJ_R3

SCALE: 1:10
UNITS: in.[mm]

SHEET:
12 of 23
DATE:
10/16/2014
DRAWN BY:
JEK/SDB
REV. BY:
JDS/SKR/
KAL

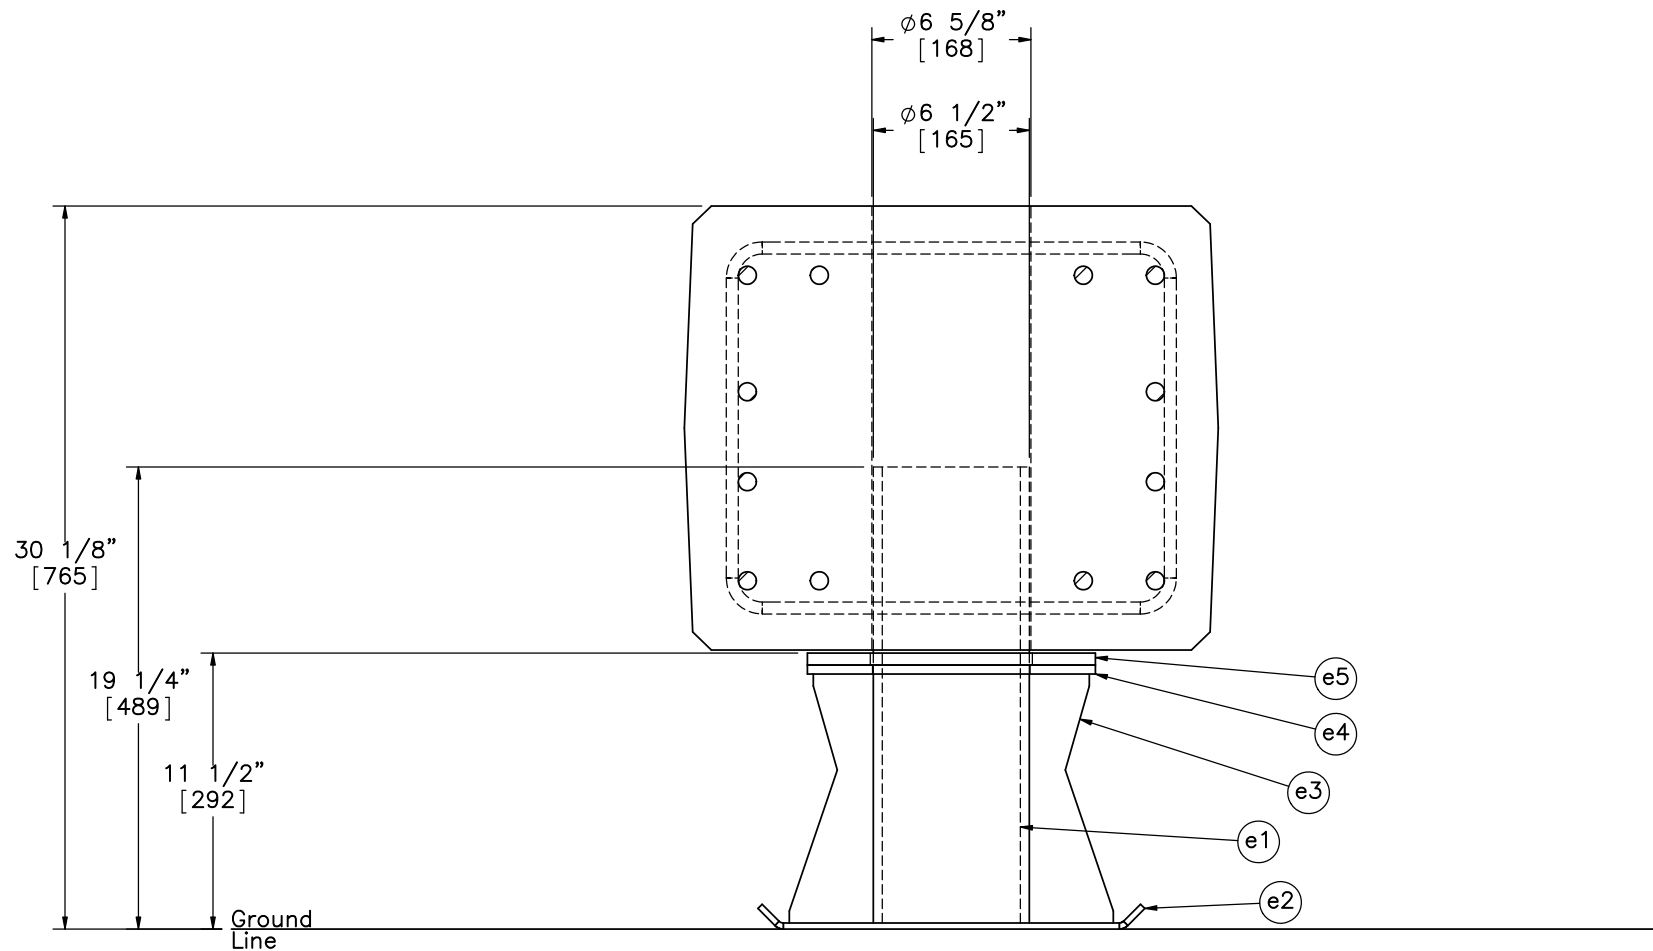

SECTION N-N

- Note:
- (1) Steel Rail not shown for clarity.
 - (2) Part e5 can compress as needed due to weight of rail.



Midwest Roadside
Safety Facility

SAFER For Highway –
Angle Joint (SFH-3)

Skid Details

DWG. NAME.
SFH-3_AJ_R3

SCALE: 1:8
UNITS: in.[mm]

SHEET:
13 of 23

DATE:
10/16/2014

DRAWN BY:
JEK/SDB

REV. BY:
JDS/SKR/
KAL

SAFER For Highway –
Angle Joint (SFH-3)

Skid Assembly Details

DWG. NAME.	SFH-3_AJ_R3
------------	-------------






SCALE: 1:8
UNITS: in.[mm]

SHEET:
14 of 23

DATE:
10/16/2014

DRAWN BY:
JEK/SDB

	REV. BY:
m]	JDS/SKR/ KAI

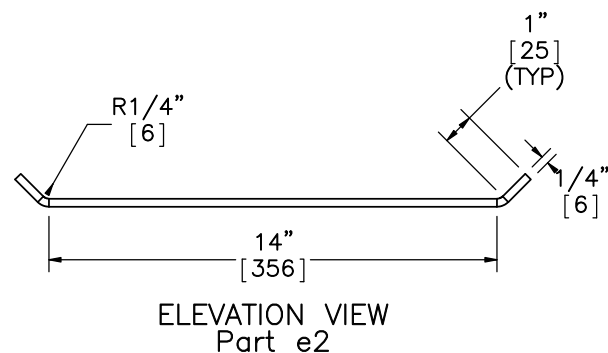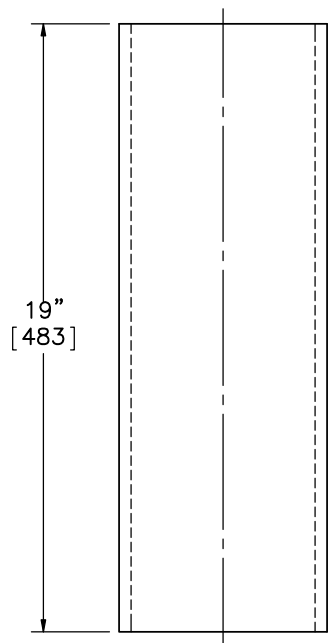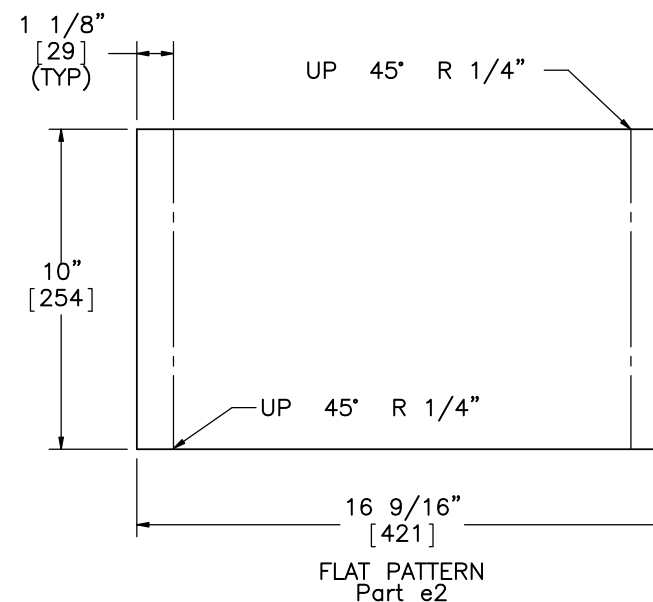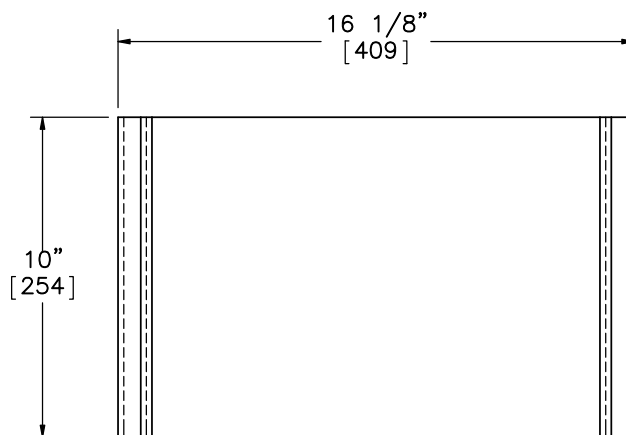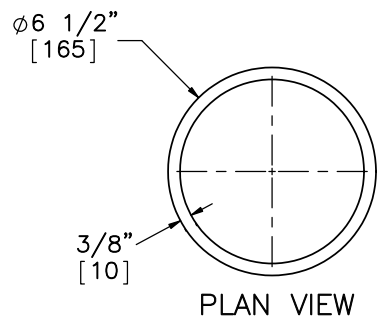

Notes: (1) Material for Part a1 can be DOM 6 1/2"x3/8", DOM 6 1/2"x1/2", or HFS 6 1/2"x1/2" or equivalent.



Midwest Roadside
Safety Facility

SAFER For Highway –
Angle Joint (SFH-3)

Skid Component Details

DWG. NAME.
SFH-3_AJ_R3


SCALE: 1:6
UNITS: in.[mm]

SHEET:
15 of 23

DATE:
10/16/2014


DRAWN BY:
JEK/SDB

REV. BY:
JDS/SKR/
KAL

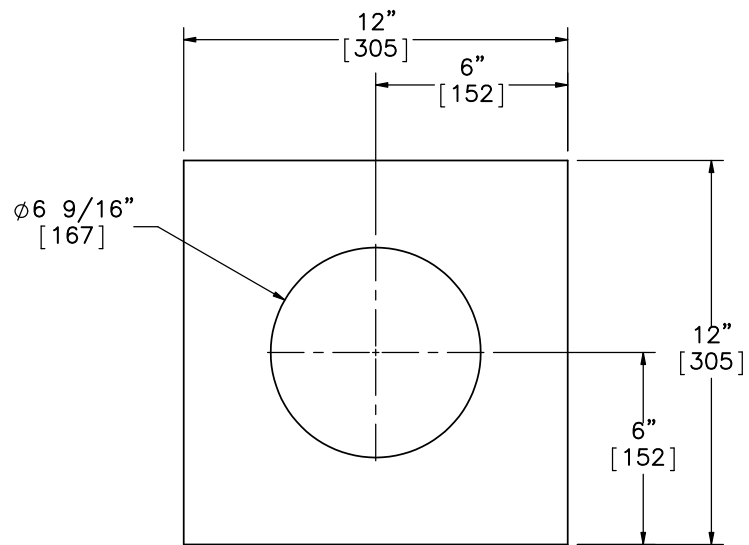


PLAN VIEW

Part e4

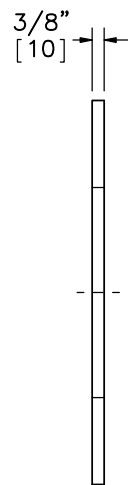


PROFILE VIEW

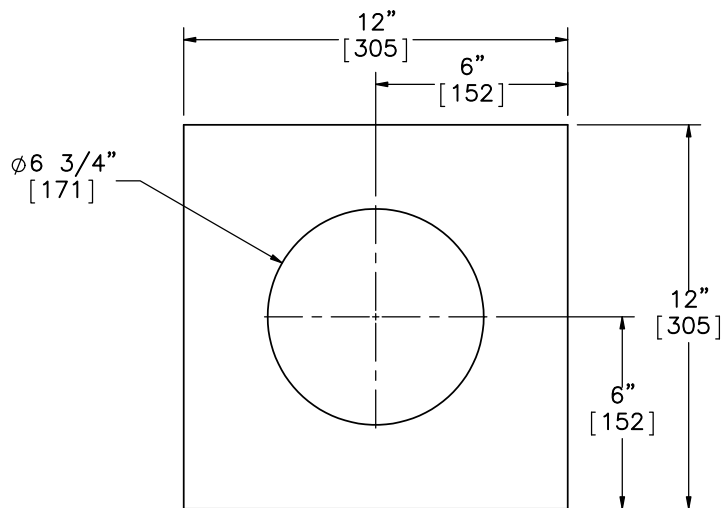


PLAN VIEW

Part e5

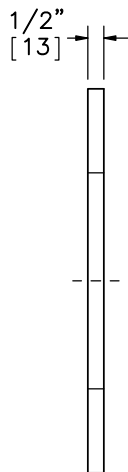


PROFILE VIEW

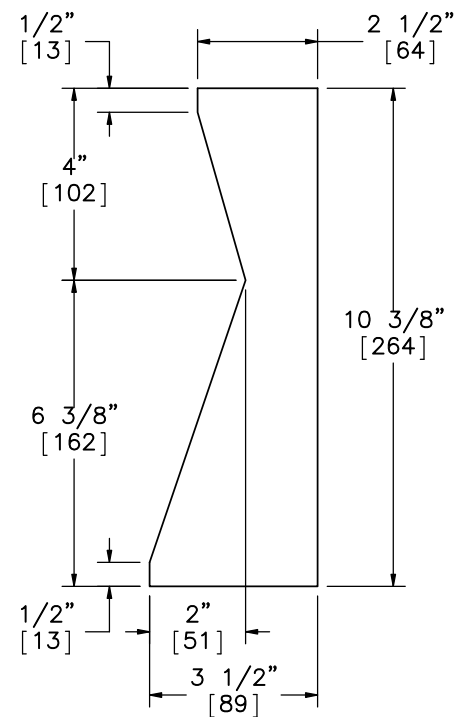

ELEVATION VIEW

Part e3
SCALE 1:4

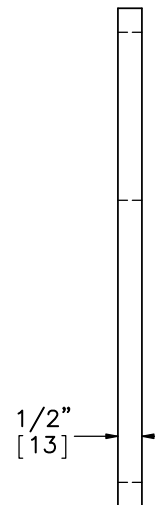

PROFILE VIEW



Midwest Roadside
Safety Facility





SAFER For Highway –
Angle Joint (SFH-3)

Skid Top Plate Detail


DWG. NAME.
SFH-3_AJ_R3

SCALE: 1:6
UNITS: in.[mm]

SHEET:
16 of 23
DATE:
10/16/2014
DRAWN BY:
JEK/SDB
REV. BY:
JDS/SKR/
KAL

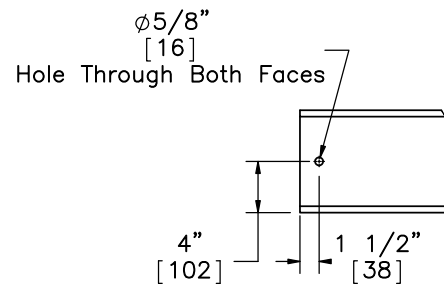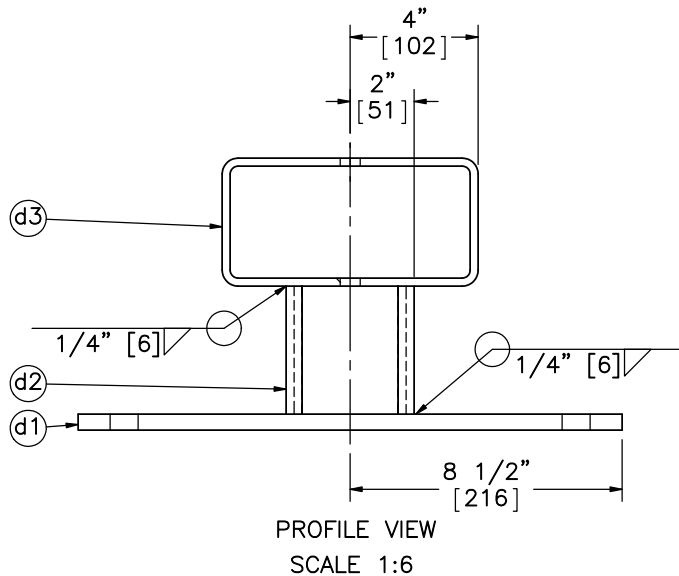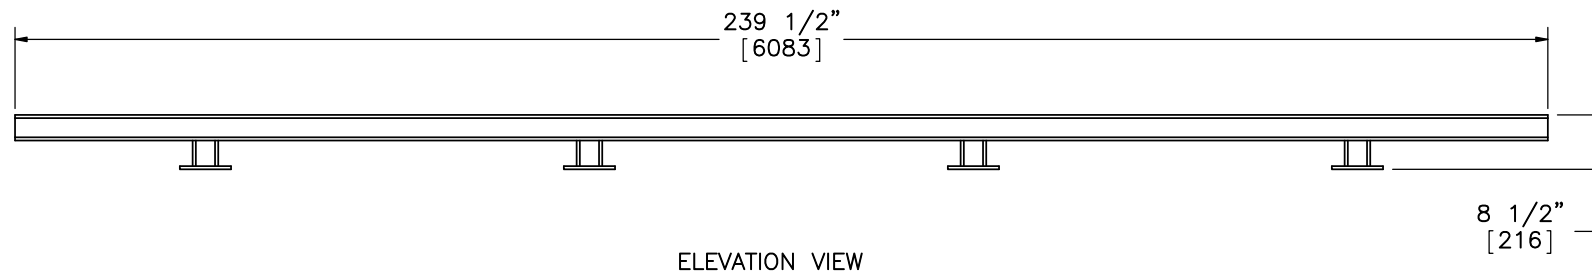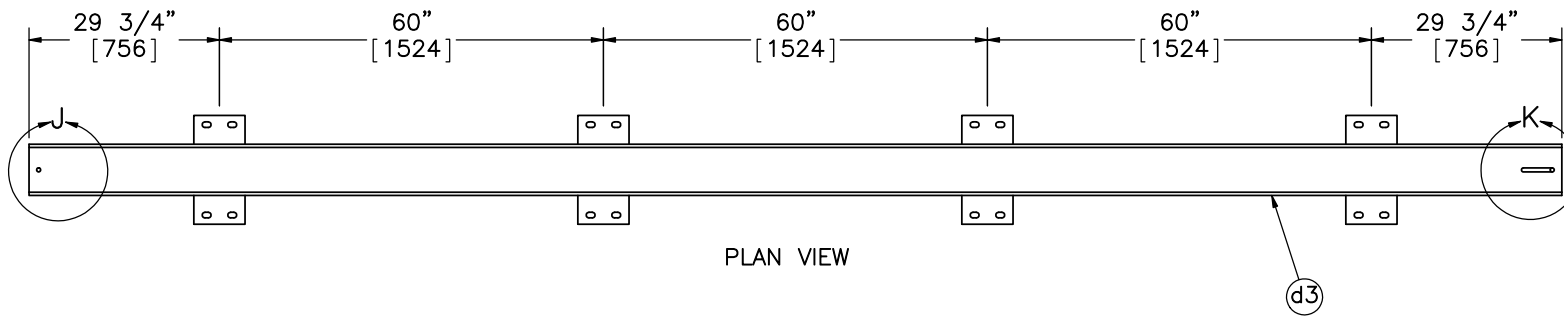






DETAIL J
SCALE 1 : 15

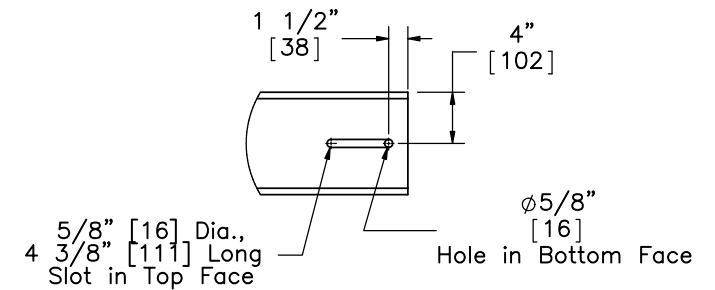

DETAIL K
SCALE 1 : 15


NOTE: (1) Dimensions are symmetric across the center line.
(2) Slot dimensions are measured to far exterior points.

	SAFER For Highway – Angle Joint (SFH-3)		SHEET: 17 of 23
	Steel Rail Assembly		DATE: 10/16/2014
Midwest Roadside Safety Facility	DWG. NAME: SFH-3_AJ_R3		DRAWN BY: JEK/SDB
	SCALE: 1:30 UNITS: in./mm		REV. BY: JDS/SKR/ KAL

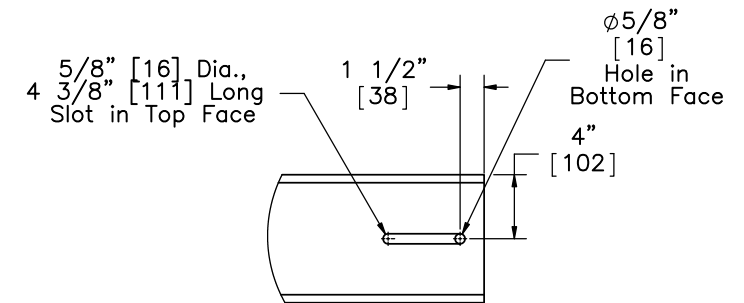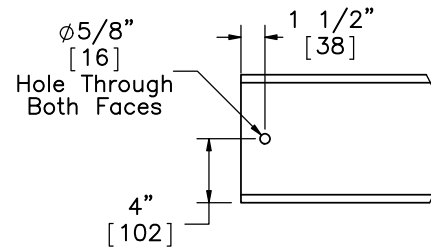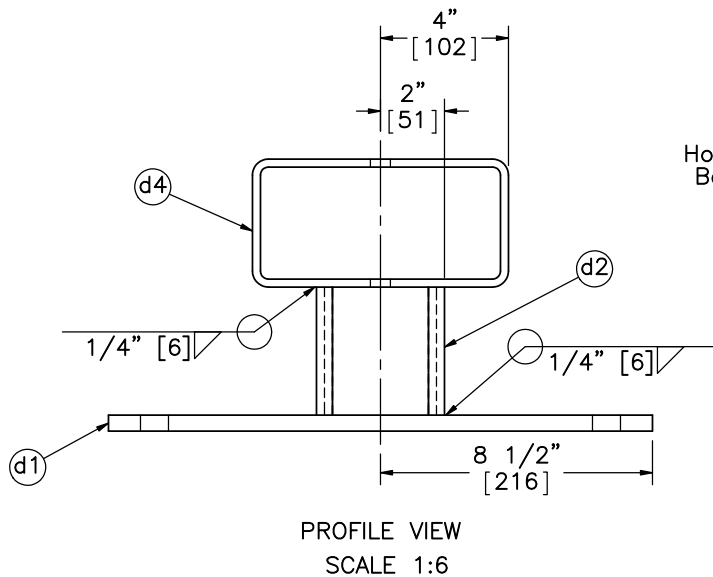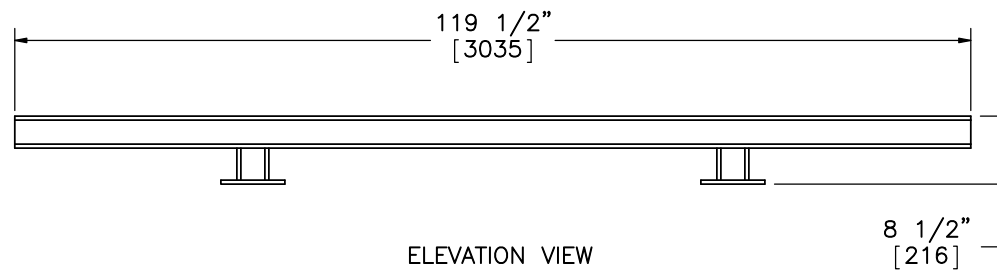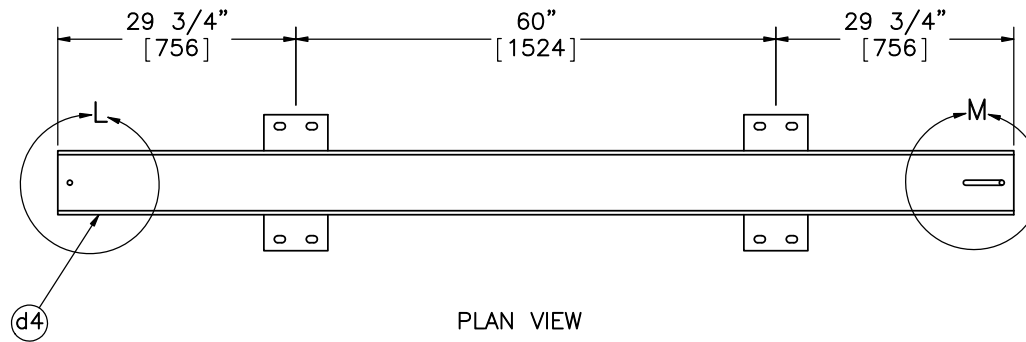


NOTE: (1) Dimensions are symmetric across the center line.
(2) Slot dimensions are measured to far exterior points.


	SAFER For Highway – Angle Joint (SFH-3)		SHEET: 18 of 23
	Steel End Tubing Assembly		DATE: 10/16/2014
Midwest Roadside Safety Facility	DWG. NAME: SFH-3_AJ_R3		DRAWN BY: JEK/SDB
	SCALE: 1:24 UNITS: in./mm		REV. BY: JDS/SKR/KAL

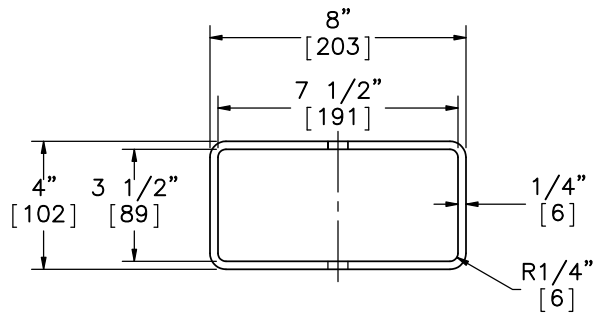

ELEVATION VIEW

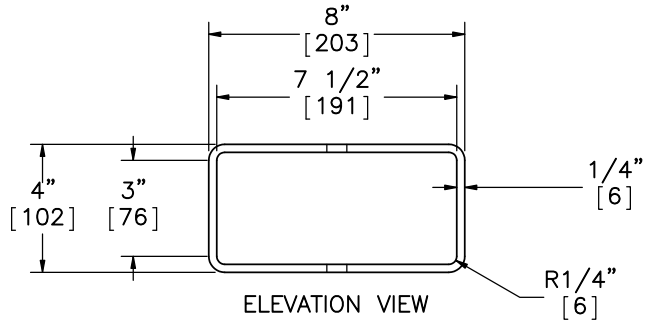


ELEVATION VIEW

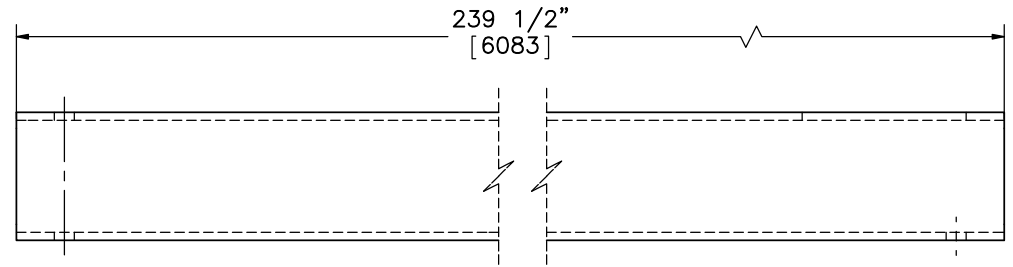


PROFILE VIEW

Part d3

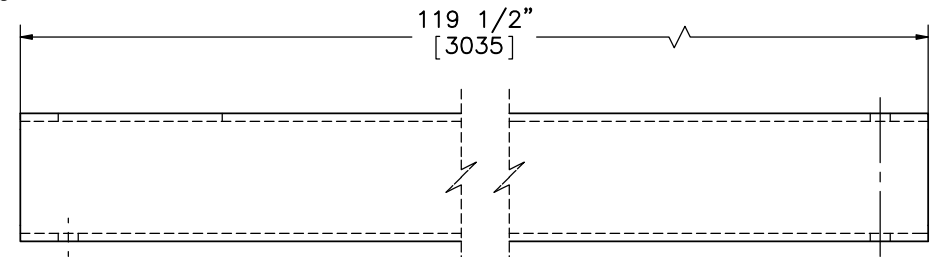

PROFILE VIEW


Parts d4

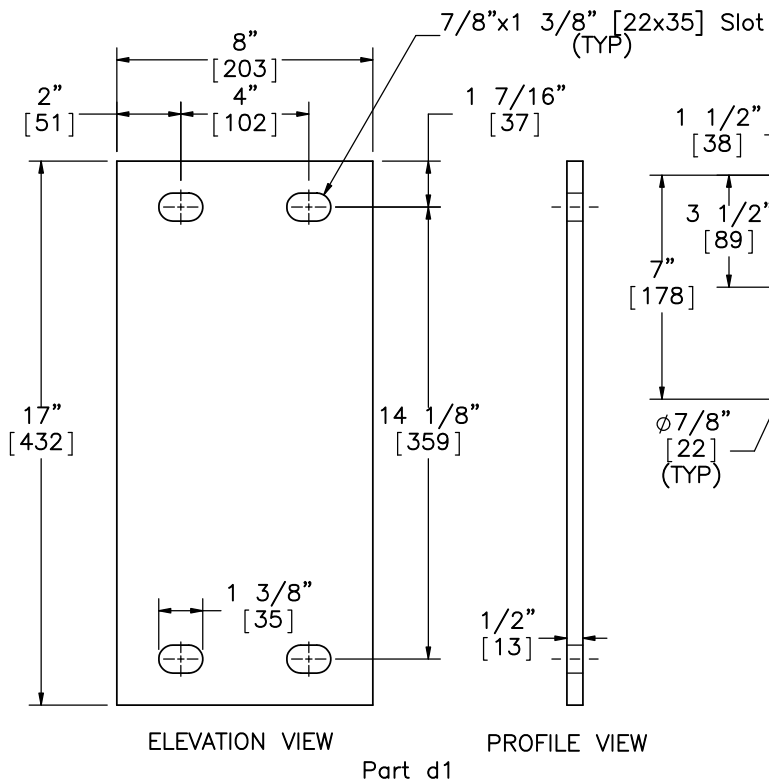

ELEVATION VIEW


PROFILE VIEW

Part d1

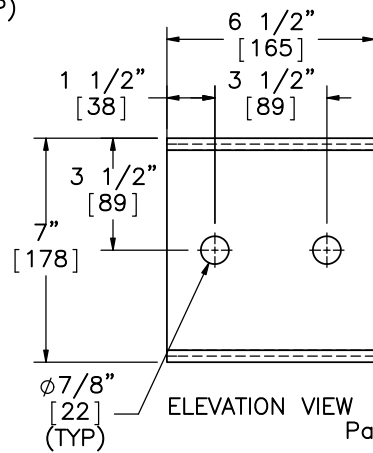


ELEVATION VIEW

Part d5

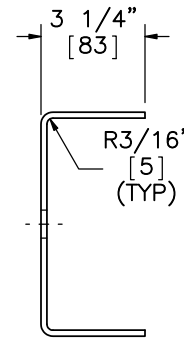

PROFILE VIEW

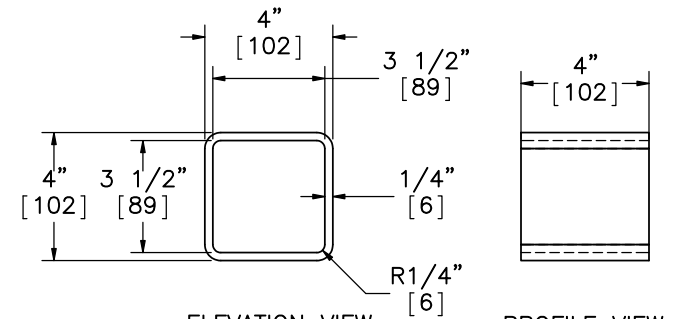

ELEVATION VIEW

PROFILE VIEW

Part d2



Midwest Roadside
Safety Facility


SAFER For Highway –
Angle Joint (SFH-3)

Steel Rail Components

DWG. NAME.
SFH-3_AJ_R3


SCALE: 1:6
UNITS: in.[mm]

SHEET:
19 of 23
DATE:
10/16/2014
DRAWN BY:
JEK/SDB
REV. BY:
JDS/SKR/
KAL

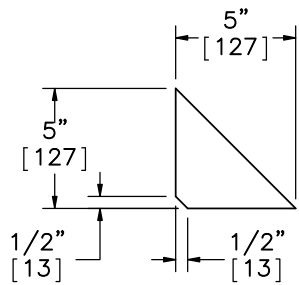


ELEVATION VIEW


Part a4

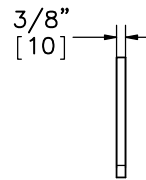


PROFILE VIEW

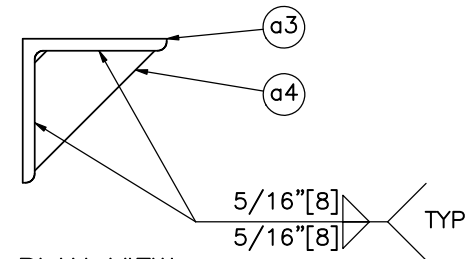

PLAN VIEW

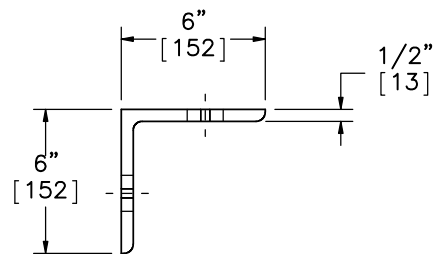


PLAN VIEW

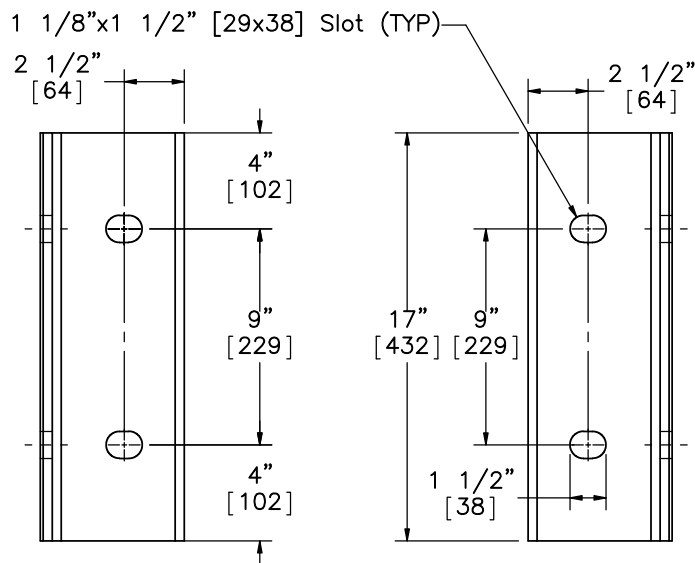

ELEVATION VIEW


Part a3

PROFILE VIEW

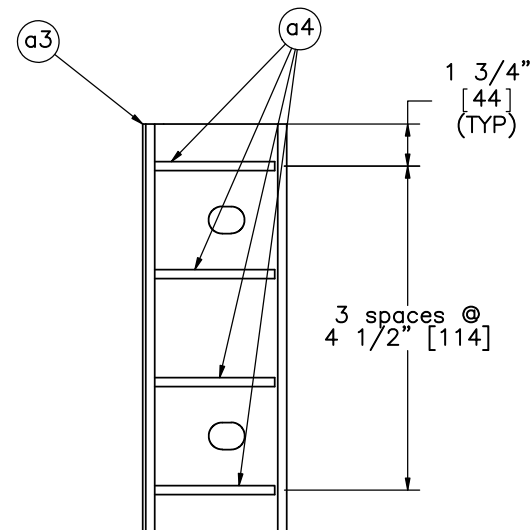

ELEVATION VIEW

- Notes: (1) Slot dimensions measured from exterior points.
(2) Dimensions shown are to center of slot.

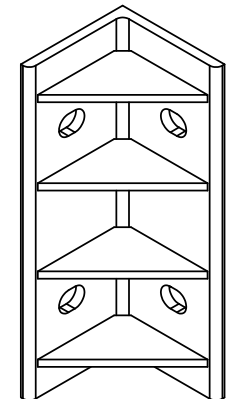

ISOMETRIC VIEW



Midwest Roadside
Safety Facility


SAFER For Highway –
Angle Joint (SFH-3)

Angle Joint Details


DWG. NAME.
SFH-3_AJ_R3

SCALE: 1:8
UNITS: in./mm


SHEET:
20 of 23
DATE:
10/16/2014
DRAWN BY:
JEK/SDB
REV. BY:
JDS/SKR/
KAL

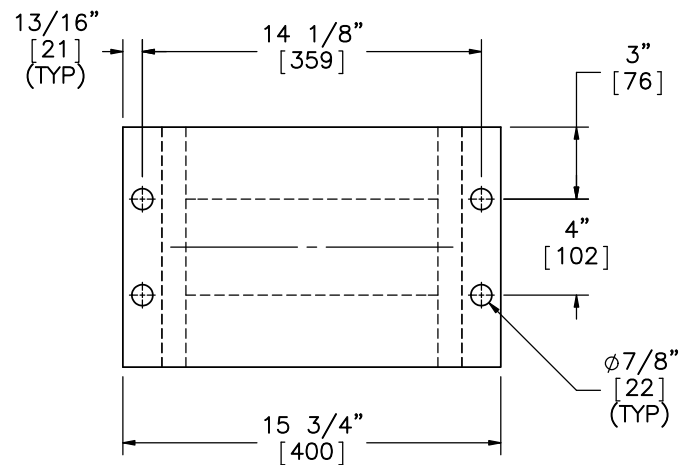


PLAN VIEW

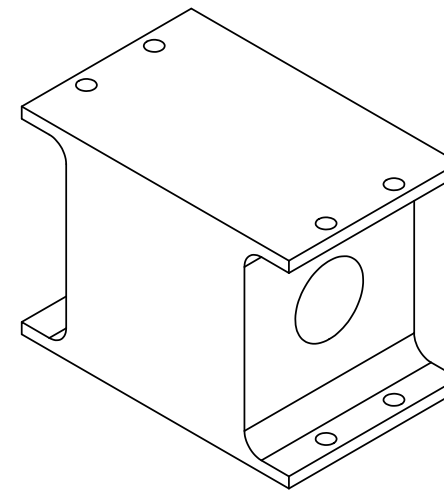

ISOMETRIC VIEW

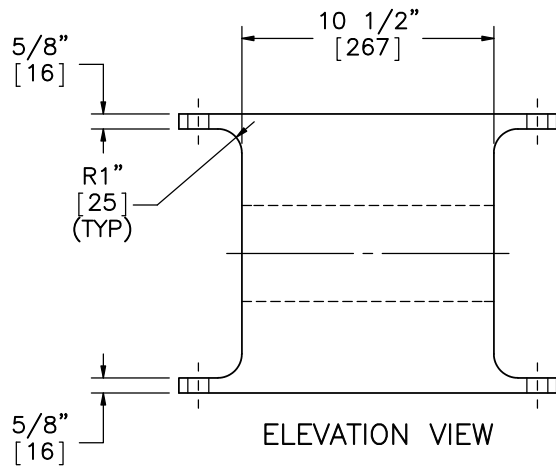


ELEVATION VIEW

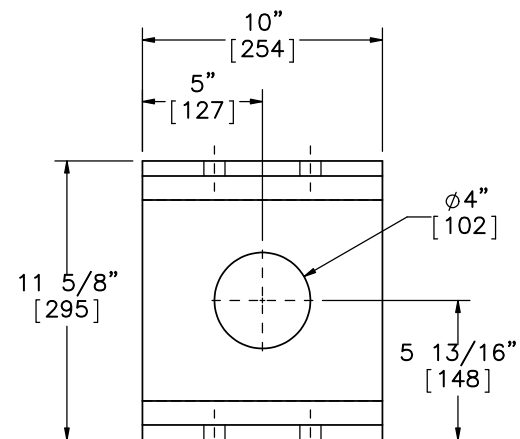

PROFILE VIEW


Part a2

	SAFER For Highway – Angle Joint (SFH-3)		SHEET: 21 of 23
	Rubber Post Details		DATE: 10/16/2014
Midwest Roadside Safety Facility	DWG. NAME: SFH-3_AJ_R3		DRAWN BY: JEK/SDB
	SCALE: 1:8 UNITS: in.[mm]		REV. BY: JDS/SKR/ KAL

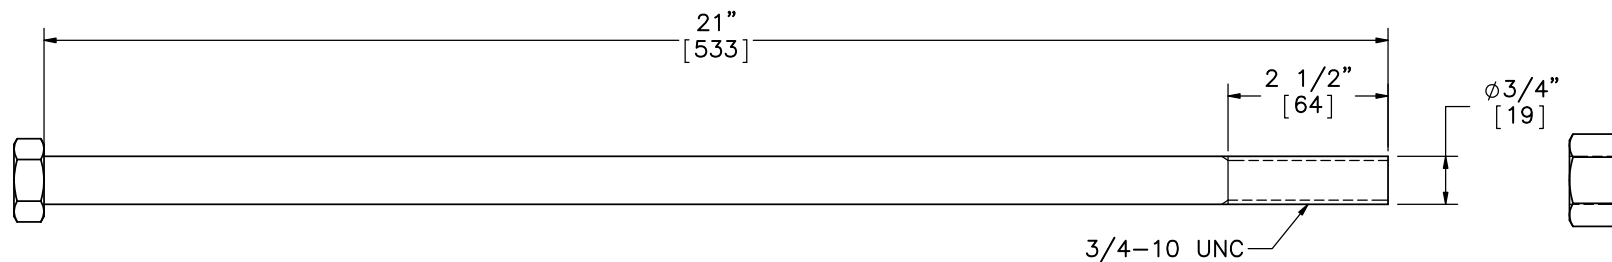


ELEVATION VIEW
Part b1

ELEVATION VIEW
Part b3

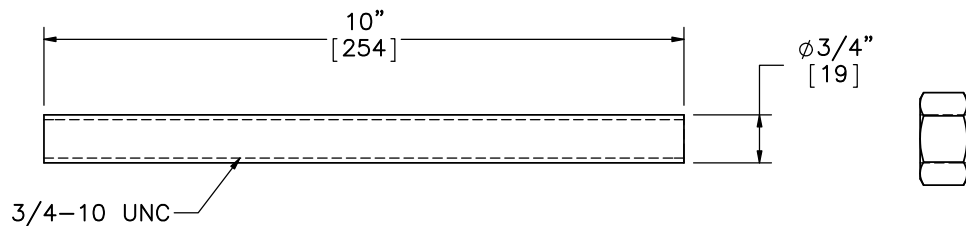


ELEVATION VIEW
Part b2

ELEVATION VIEW
Part b3

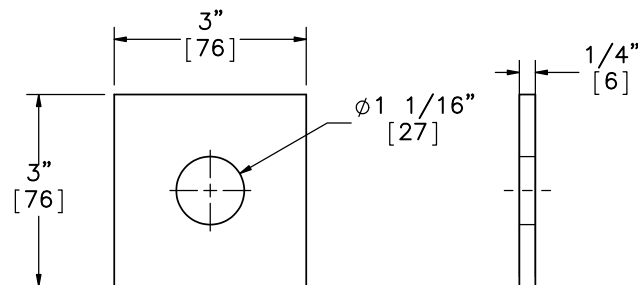


ELEVATION VIEW PROFILE VIEW
Part b6

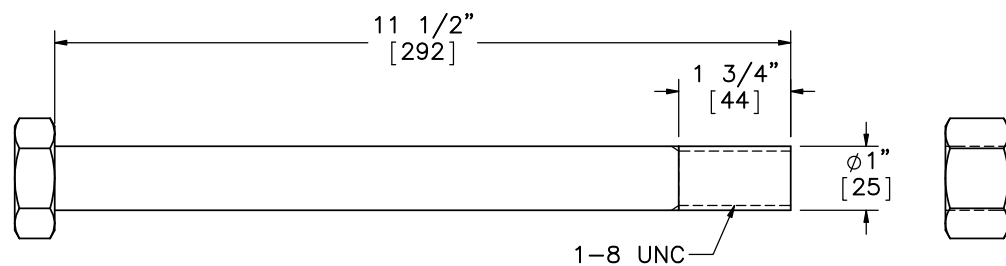


ELEVATION VIEW
Part b5

ELEVATION VIEW
Part b7

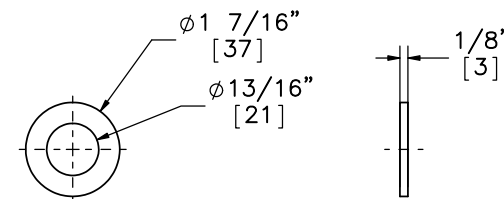

ELEVATION VIEW PROFILE VIEW
Part b4

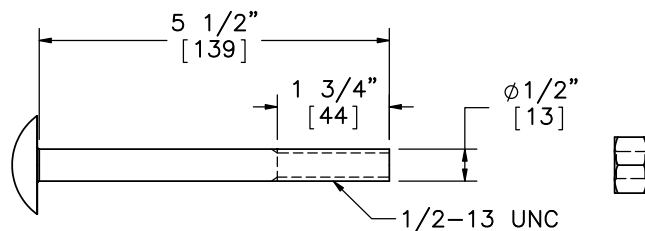

ELEVATION VIEW
Part d6

ELEVATION VIEW
Part d8



Midwest Roadside
Safety Facility

SAFER For Highway -
Angle Joint (SFH-3)

Fastener Details

DWG. NAME.
SFH-3_AJ_R3

SCALE: 1:3
UNITS: in.[mm]

SHEET:
22 of 23
DATE:
10/16/2014
DRAWN BY:
JEK/SDB
REV. BY:
JDS/SKR/
KAL

Item No.	QTY.	Description	Material Specification	Hardware Guide	
a1	12	Lightweight Concrete Rail	min f'c=5 ksi [34.5 MPa], density=110 pcf	—	
a2	48	Morse E46496 Shear Fender	ASTM D2000	—	
a3	22	6"x6"x1/2" [152x152x13], 17" [432] Long L-Bracket	A992 Galvanized	—	
a4	88	5"x5"x3/8" [127x127x10] Gusset Plate	A572 Grade 50 Galvanized	—	
b1	192	3/4" [19] Dia. UNC, 21" [533] Long Hex Bolt	Grade 5 Galvanized	FBX20a	
b2	192	3/4" [19] Dia. UNC, 10" [254] Long Threaded Rod	ASTM A193 Grade B7 Galvanized	—	
b3	384	3/4" [19] Dia. UNC Heavy Hex Nut	ASTM A194 Grade 2H Galv.	—	
b4	576	3/4" [19] Dia. Flat Washer	ASTM F436 Galv.	—	
b5	88	1" [25] Dia. UNC, 11 1/2" [292] Long Hex Head Bolt	ASTM A325 Galv.	FBX24b	
b6	176	3"x3"x1/4" [76x76x6] Square Washer	A572 Grade 50 Galvanized	—	
b7	88	1" [25] Dia. UNC Heavy Hex Nut	ASTM A563 DH Galv.	FNX24b	
c1	336	1/2" [13] Dia., 77" [1956] Long Bent Rebar	A615 Grade 60	—	
c2	96	1/2" [13] Dia., 49" [1245] Long Bent Rebar	A615 Grade 60	—	
c3	144	3/4" [19] Dia., 231" [5867] Long Rebar	A615 Grade 60	—	
c4	96	3/4" [19] Dia., 63" [1600] Long Bent Rebar	A615 Grade 60	—	
c5	72	3/4" [19] Dia., 69" [1753] Long Bent Rebar	A615 Grade 60	—	
d1	48	17"x8"x1/2" [431x203x13] Anchor Plate	ASTM A572 Grade 50 Galvanized	—	
d2	48	4"x4"x1/4" [102x102x6], 4" [102] Long Tube	A500 Grade B Galvanized	—	
d3	11	8"x4"x1/4" [203x102x6], 239 1/2" [6083] Long Tube	A500 Grade B Galvanized	—	
d4	2	8"x4"x1/4" [203x102x6], 119 1/2" [3035] Long End Tube	A500 Grade B Galvanized	—	
d5	12	12 3/4"x6 1/2"x3/16" [324x165x5] Bent Plate	ASTM A572 Grade 50 Galvanized	—	
d6	24	1/2" [13] Dia. UNC, 5 1/2" [140] Long Dome (Round) Head Bolt	ASTM A307 Grade A Galvanized	—	
d7	24	1/2" [13] Dia. Flat Washer	ASTM F844 Galvanized	FWC12a	
d8	24	1/2" [13] Dia. UNC Heavy Hex Nut	A563A Galvanized	FNX12b	
d9	—	Epoxy	HILTI HIT-RE500	—	
e1	24	6 1/2" [165] Dia., 3/8" [10] Thick, 19" [483] Long Steel Pipe	AISI 1026	—	
e2	24	16 9/16"x10"x1/4" [421x254x6] Base Plate	ASTM A572 Grade 50 Steel	—	
e3	48	3 1/2"x10 3/8"x1/2" [89x264x13] Plate Gusset	ASTM A572 Grade 50 Steel	—	
e4	24	12"x12"x3/8" [305x305x10] Top Plate	ASTM A572 Grade 50 Steel	—	
e5	24	12"x12"x1/2" [305x305x13] EPDM Rubber Sheet	Minimum 50 durometer	—	
 Midwest Roadside Safety Facility			SAFER For Highway – Angle Joint (SFH-3)		SHEET: 23 of 23
			Bill of Materials		DATE: 10/16/2014
					DRAWN BY: JEK/SDB
			DWG. NAME: SFH-3_AJ_R3	SCALE: 1:8 UNITS: in.[mm]	REV. BY: JDS/SKR/ KAL

REV.	DATE OF ISSUE	Page	NATURE OF CHANGES	REVISED BY
R0	8/26/2014	–	Drawing originated from SFH_AJ_R7.	JEK
		1	Impact location moved to 60" US of the joint between 5 and 6. Impact angle changed. Test vehicle changed. Barriers labeled to indicate where barriers previously used in test shall be placed. Note 1 corrected. Notes 3 and 4 added. General format changes. General dimension changes.	
		5	Optional note added to the spice instrumentation.	
R1	8/28/2014	–	Part b1 switched to a 21" hex head bolt.	JEK
		1	Note 5 added. Barrier layout rearranged.	
		3	Part b1 replaced. Nut on top of barrier removed.	
		22	Part b1 replaced. New part dimensioned.	
		23	Part b1 replaced. Description and material of b1 changed. Quantity of b3 changed.	
R2	10/15/2014	–	Rebar corrected to "as built" and hardware changed to cosmetic thread.	SDB
		8	Note 1 added.	
		9	Rebar corrected to CI drawings.	
		10	Rebar corrected to CI drawings.	
		11	Rebar corrected to CI drawings.	
		12	Rebar corrected to CI drawings. Parts c1–c5 length and assembly dimensions corrected.	
		22	Hardware changed to cosmetic threads. Part d6 and d8 added to page	
		23	Nuts and Bolts separated into two parts. Hardware guide designations added to parts b4, b7, d7, and d8.	
R3	10/16/2014	3	Part b1 corrected back to bolt.	SDB
		22	Part b1 corrected back to bolt.	
		23	Part b1 replaced. Description and material of b1 changed. Quantity of b3 changed.	